


FINAL PROOF MAP RECEIVED

Located in the SE 1/4 NE 1/4
Township 20 South, Range 11 West, W.M.
Douglas County, Oregon

JAN 23 1998
WATER RESOURCES DEPT.
SALEM, OREGON

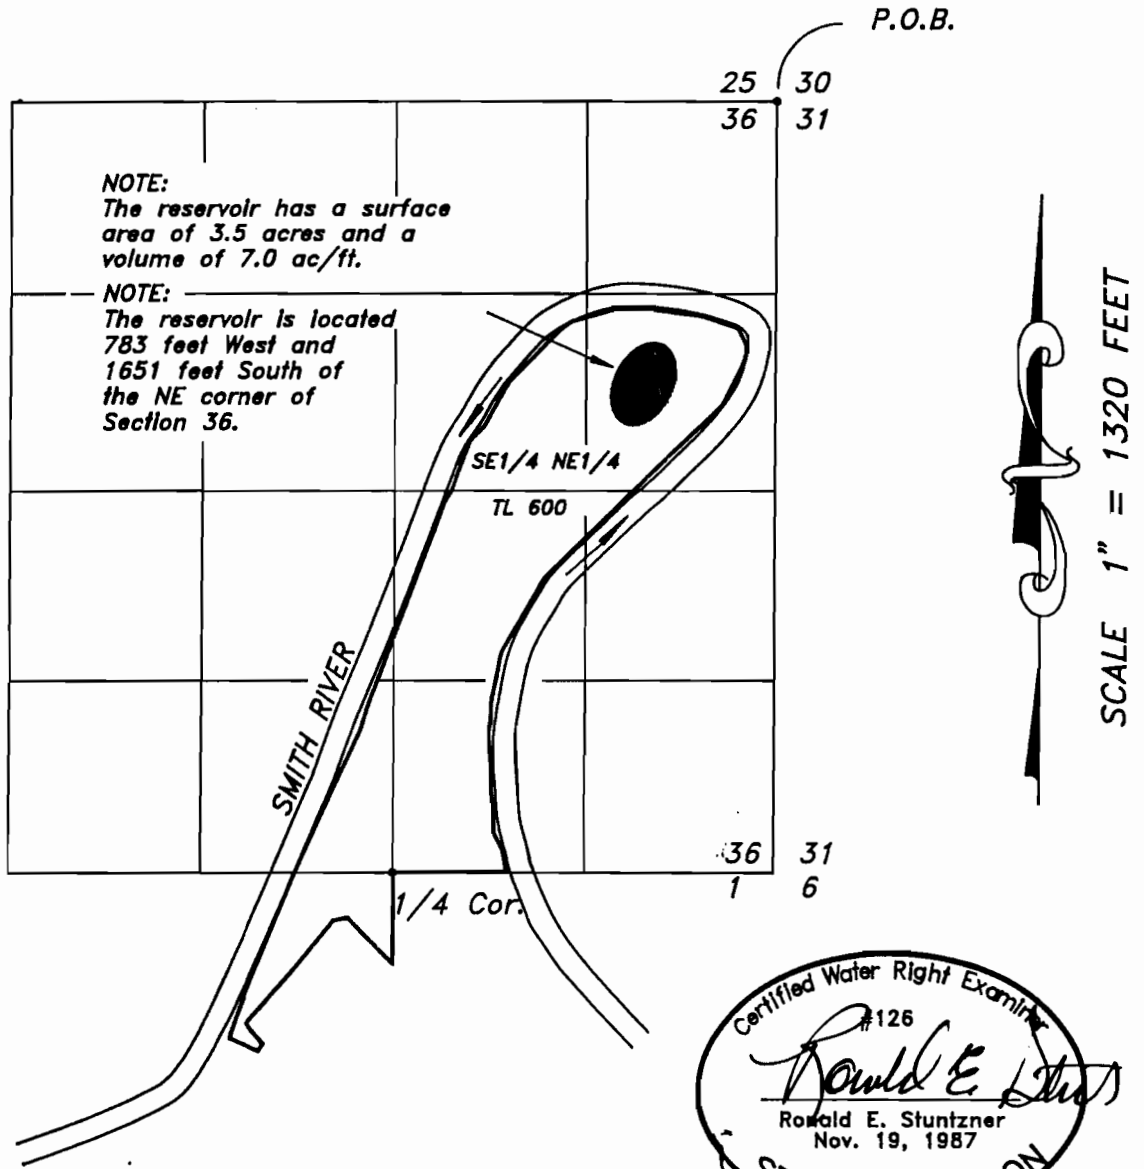

Prepared For: Tracy Fletz
Prepared By: Dennis Goude
Date Surveyed: April 2, 1997

Certified Water Right Examiner
#126
Ronald E. Stuntzner
Ronald E. Stuntzner
Nov. 19, 1987
STATE OF OREGON
EXPIRES 06/30/98

*Stuntzner Engineering
& Forestry, LLC*
ENGINEERING * LAND SURVEYING * FORESTRY
PLANNING * WATER RIGHTS
705 South 4th St.
Post Office Box 118
Coos Bay, Oregon 97420
Phone (541) 267-2872
Fax (541) 267-0588