


RECEIVED

AUG 05 1998

WATER RESOURCES DEPT.
SALEM, OREGON

T 33 S, R 31 E, WM

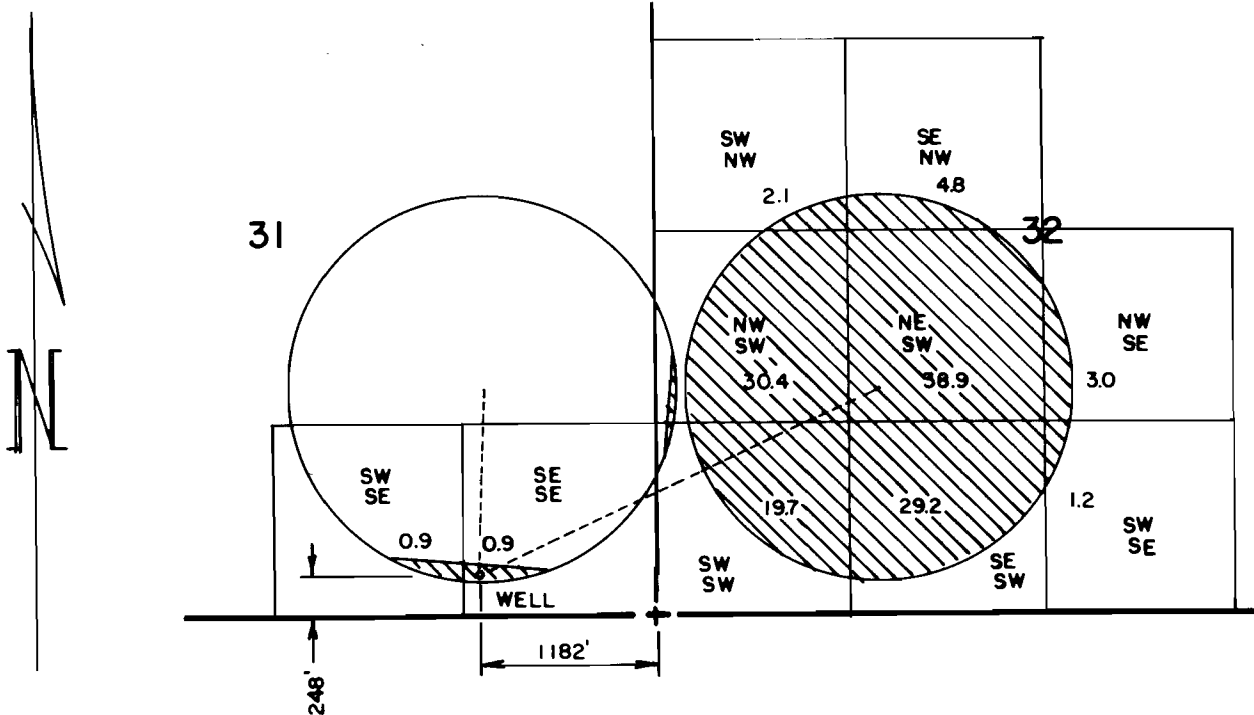

THE PURPOSE OF THIS MAP IS TO
IDENTIFY THE LOCATION OF THE
WATER RIGHT. IT IS NOT INTENDED
TO PROVIDE INFORMATION RELATIVE
TO THE LOCATION OF PROPERTY
OWNERSHIP.

FINAL PROOF SURVEY

UNDER
T-7280

IN THE NAME OF
REX CLEMEN RANCH, INC

Scale: 4 = 1 MILE

Date: JULY 1998

Job: 1312-98

Drawn:

Dm: CHRIS

Ckd:

MAP's

M. A. PALMER & SONS, INC.
ENGINEERING & SURVEYING
284 N. Alder - Box 61
Burns, Oregon 97720

Sht. No.

of 1

