
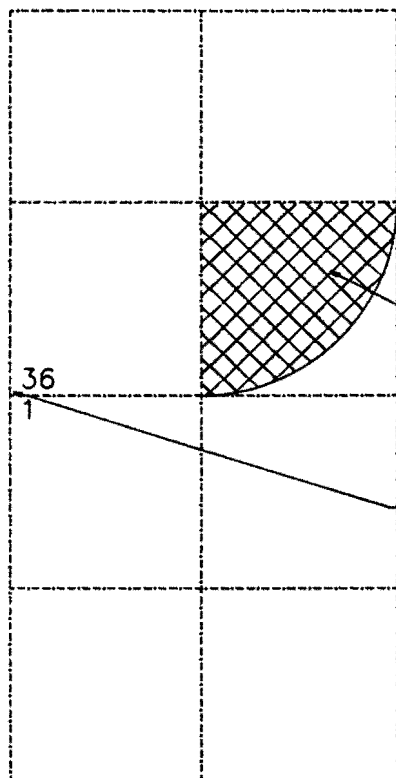


RECEIVED

DEC 16 1998


WATER RESOURCES DEPT.
SALEM, OREGON

WATER RIGHTS TRANSFER T-6674
FLOWERREE FARMS
CHRISTMAS VALLEY, OREGON

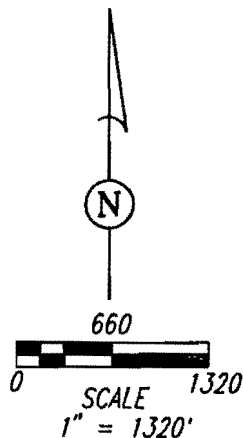

Irrigated area 32.0 acres.

well is located 30 ft. east and 30 ft north
of the southwest corner of Section 36.

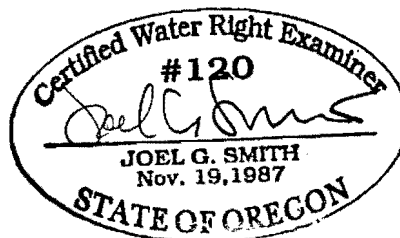


RENEWES 6/30/00

12/6/98

I, Joel G. Smith, Certified Water Rights Examiner No. 120, do
hereby certify that this map was prepared under my direction.

This map has been prepared to identify the location of a
water right and does not represent property ownership or
boundary lines.

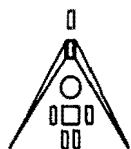

TERRASCOPE, INC.
405 SW Eighth St
Redmond, OR 97756
Tel: (541) 548-7852
Fax: (541) 548-7854

FINAL PROOF SURVEY
SEC 36, T26S, R18E, WM
LAKE COUNTY, OR

DRAWING NO: F601-2
DATE: 12/4/98
DRAWN BY: JGS
CHECKED BY: CB
PROJECT NO: F117-600