
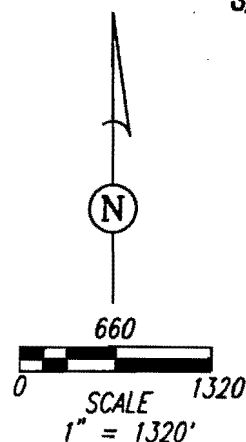



RECEIVED

DEC 16 1998
WATER RESOURCES DEPT.
SALEM, OREGON

WATER RIGHTS TRANSFER T-7324
FLOWERREE FARMS
CHRISTMAS VALLEY, OREGON

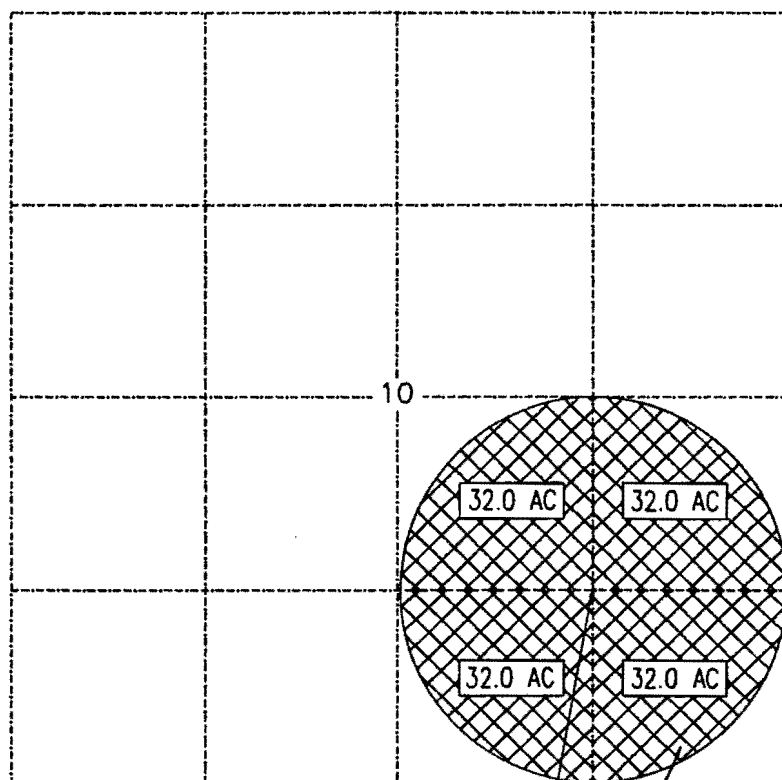

Well is located 1325 ft. south and 1325 ft.
east of the center of Section 10.
Irrigated area, areas noted.

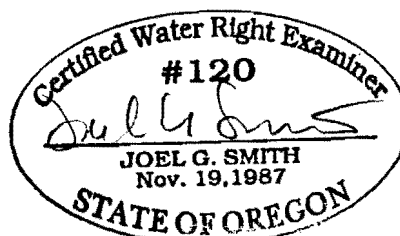


RENEWS 6/30/00

12/6/98

I, Joel G. Smith, Certified Water Rights Examiner No. 120, do
hereby certify that this map was prepared under my direction.

This map has been prepared to identify the location of a
water right and does not represent property ownership or
boundary lines.

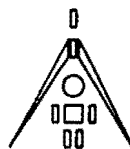

405 SW Eighth St
Redmond, OR 97756
Tel: (541) 548-7852
Fax: (541) 548-7854

FINAL PROOF SURVEY
SEC 10, T27S, R118E, WM
LAKE COUNTY, OR

DRAWING NO: F997-3
DATE: 12/4/98
DRAWN BY: JGS
CHECKED BY: CB
PROJECT NO: F117-600