


T. 8S., R. 42E., W.M.

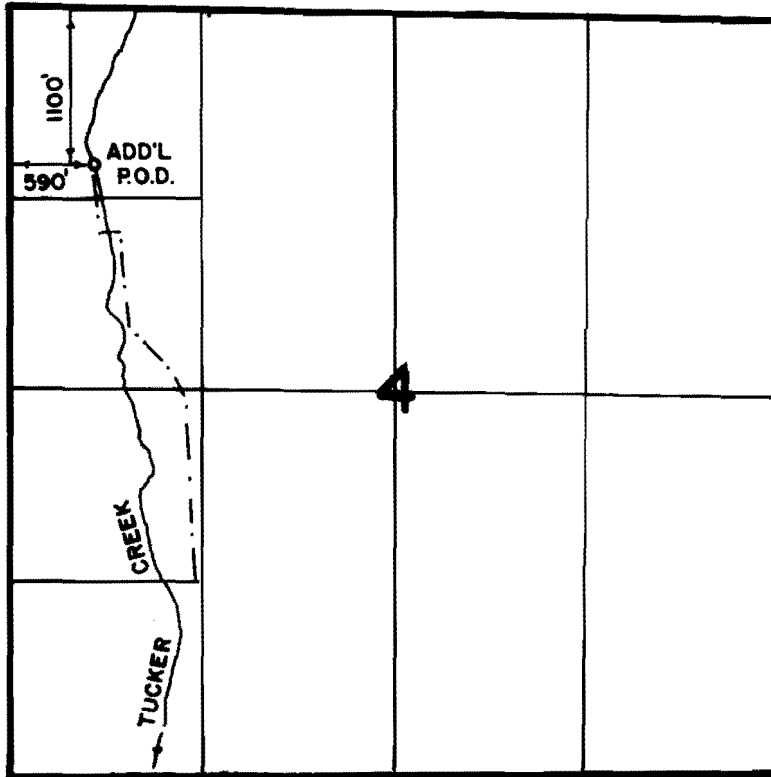

Scale 1" = 1320'

THE PURPOSE OF THIS MAP IS FOR IDENTIFYING THE LOCATION OF THE WATER RIGHT ONLY AND IS NOT INTENDED TO PROVIDE LEGAL DIMENSIONS OF PROPERTY OWNERSHIP LINES.

FINAL PROOF SURVEY


TRANSFER 6934

IN NAME OF

Robert & Virginia Lowry

Surveyed

Sept. 16, 1998

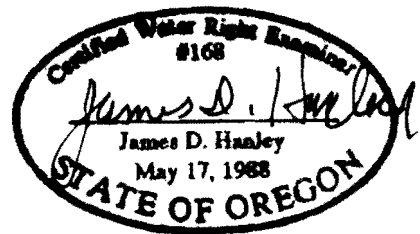

RECEIVED

SEP 29 1998

WATER RESOURCES DEPT.
SALEM, OREGON