





NOTE: THIS MAP WAS PREPARED FOR THE PURPOSE OF IDENTIFYING THE LOCATION OF WATER RIGHTS. THIS MAP IS NOT INTENDED TO PROVIDE LEGAL DIMENSIONS OR LOCATIONS OF PROPERTY OWNERSHIP LINES.


SCALE

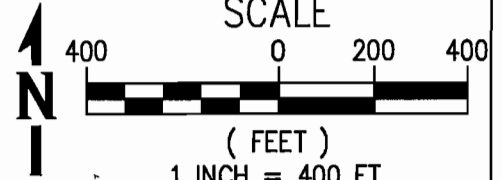

MILLER TREE FARM, LLC
CLAIM OF BENEFICIAL USE MAP
OCTOBER 2011
PERMIT R-14026
SW $\frac{1}{4}$ SE $\frac{1}{4}$, SECTION 34,
T 17 S, R 11 E, W.M.
DESCHUTES COUNTY, OR

LEGEND

-  RESERVOIR LOCATION
-  EXISTING DITCH
-  EXISTING CORRUGATED METAL PIPE

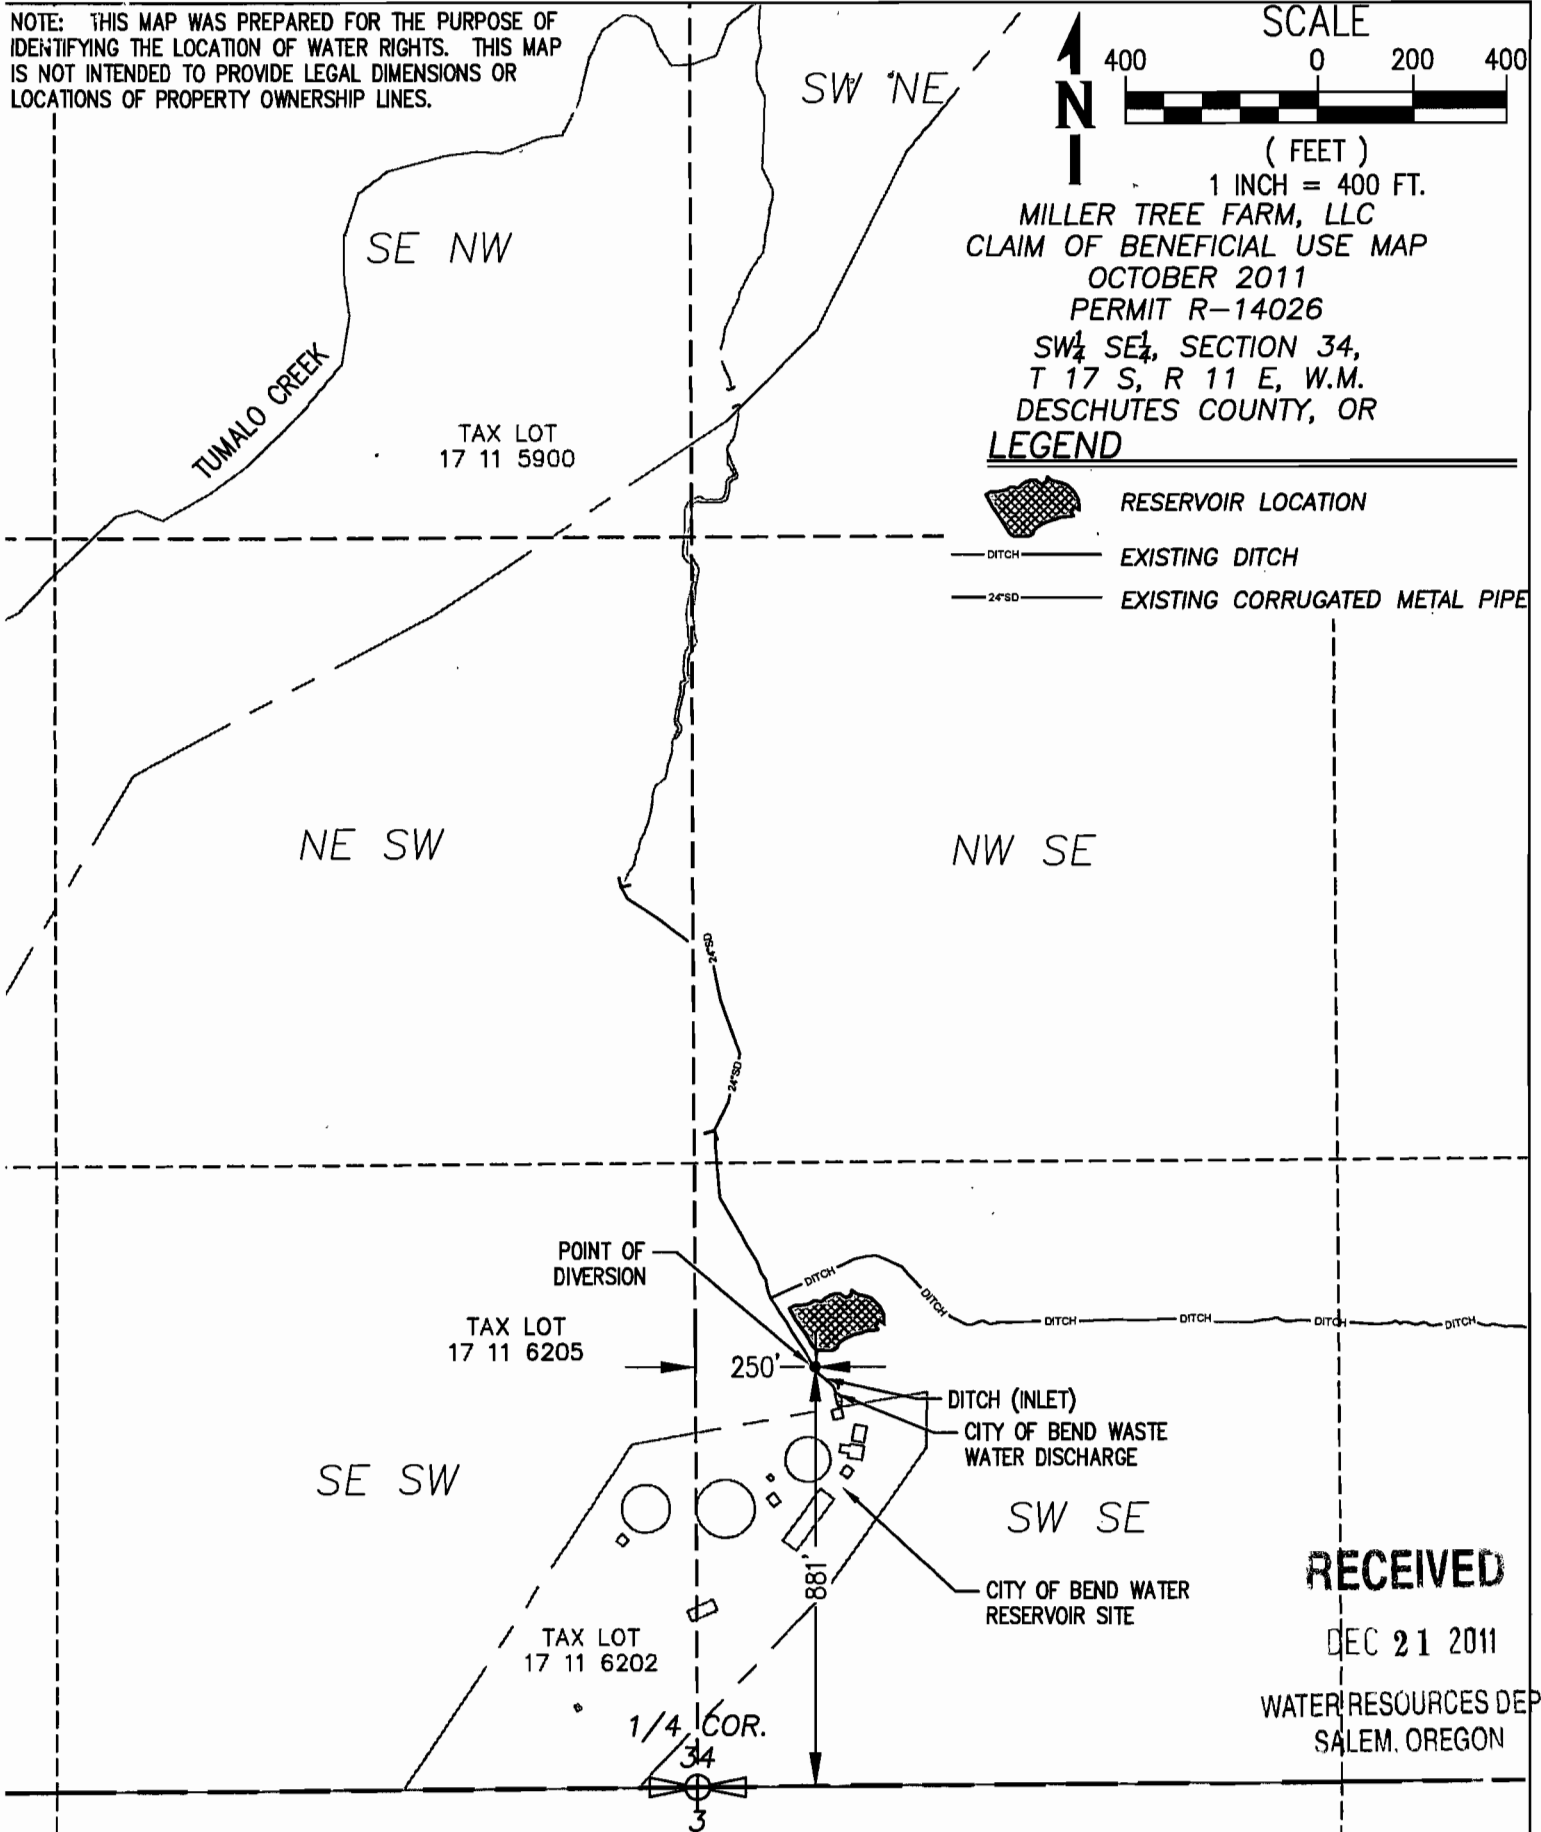

RECEIVED

DEC 21 2011

WATER RESOURCES DEPT
SALEM, OREGON

SHEET NUMBER
WR1.0

CLAIM OF BENEFICIAL USE MAP
PERMIT R-14026
MILLER TREE FARM, LLC
MILLER TREE FARM

DRAWING INFO
035666
035666-WR-PERMIT R-14026 COBU MAP
1"=400'

SHEET INFO
DRAWN NWB
CHECKED NWB
LAST EDIT 11/2/2011
PLOT DATE 11/7/2011

