




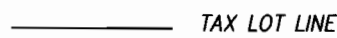
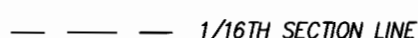



CLAIM OF BENEFICIAL USE MAP
SECTION 7, T5S, R1E AND SECTIONS 1 AND 12 T5S, R1W, WM

LOTS 1300, 1400 AND 1500 OF TAX MAP 5 1E 7 AND
LOTS 100, 101, 400, 500, 600, 601, 701 AND 1202 OF
TAX MAP 5 1W 12

CLACKAMAS COUNTY, OREGON
WILLAMETTE RIVER BASIN
APPLICATIONS G-12267, G-13453, R-73446 AND S-73447
PERMITS S-11369, G-12383, R-11494 AND S-51529


PREPARED FOR:
WEST COAST TRUST, TRUSTEE
FRANK J. BRONEC TRUST UTD 09/12/05
P.O. BOX 1012
SALEM, OREGON 97308

-  PRIMARY IRRIGATION PER PERMIT 11369 AND SUPPLEMENTAL IRRIGATION PER PERMIT S-51529
-  PRIMARY IRRIGATION PER PERMIT 12383 AND SUPPLEMENTAL IRRIGATION PER PERMIT S-51529
-  WELL
-  EXISTING MAIN IRRIGATION PIPES
-  PROPERTY BOUNDARY LINE
-  TAX LOT LINE
-  1/16TH SECTION LINE
-  DLC LINE

IRRIGATED AREA SUMMARY (ACRES)

TOWNSHIP	RANGE	MERIDIAN	SECTION	QUARTER/QUARTER	GOV. LOT	DLC	PRIMARY IRRIGATION AREA PERMIT G-11369	PRIMARY IRRIGATION AREA PERMIT G-12383	SUPPLEMENTAL IRRIGATION AREA, PERMIT S-51529
5S	1W	WM	1	SW-SE	71	2.7			2.7
5S	1W	WM	1	SE-SE	71	3.0			3.0
5S	1W	WM	12	NE-NE	71	18.2	10.7		28.9
5S	1W	WM	12	NW-NE	71	8.3	30.0		38.3
5S	1W	WM	12	SW-NE	71			36.5	36.5
5S	1W	WM	12	SE-NE	71			27.0	27.0
5S	1W	WM	12	NE-NW	71	10.0			10.0
5S	1W	WM	12	SE-NW	71	14.3			14.3
5S	1W	WM	12	SW-NE	72	3.6			3.6
5S	1W	WM	12	SE-NE	72	3.0			3.0
5S	1W	WM	12	NE-SW	72	1.3			1.3
5S	1W	WM	12	SE-SW	72	0.9			0.9
5S	1W	WM	12	NE-SE	72	34.6			34.6
5S	1W	WM	12	NW-SE	72	37.2			37.2
5S	1W	WM	12	SW-SE	72	6.2			6.2
5S	1E	WM	7	SW-NW	3	1.0			1.0
5S	1E	WM	7	NW-SW		4.8			4.8
TOTAL							149.1	104.2	253.3

RECEIVED
SEP 23 2011
WATER RESOURCES DEPT
SALEM OREGON

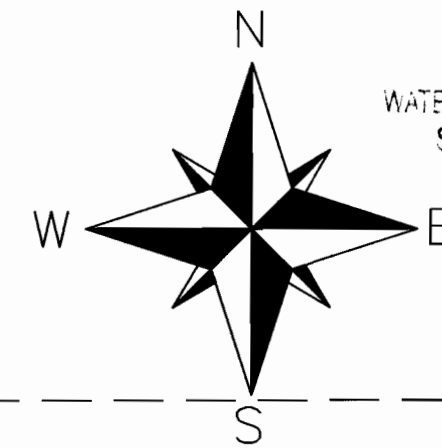

Certified Water Right Examiner
59859
Kaid E. McKay
KAID EDWARD MCKAY
MAY 21, 2010
STATE OF OREGON
EXPIRES: 12-31-2012

Stuntzner
Engineering & Forestry, LLC
ENGINEERING • LAND SURVEYING • FORESTRY
PLANNING • WATER RIGHTS

2137 19TH AVENUE
FOREST GROVE, OR 97116
INFO@STUNTZNER.COM
PHONE: (503) 357-5717
FAX: (503) 357-5698

DRAWN BY: KAID E. MCKAY	DWG: 3102057A COBU.dwg
CHECKED BY: ERIC A. URSTADT	DATE: AUGUST 19, 2011
DESIGNED BY: KAID E. MCKAY	REVISED:
JOB NAME: BRONEC FAMILY COBU	SHEET 1 OF 1

MAP IS BASED ON ASSESSORS MAPS OF T5S R1W SECTION 12 AND T5S R1E SECTION 7 AND A 2010 AERIAL PHOTO RECEIVED FROM GOOGLE EARTH.

THIS MAP WAS PREPARED FOR THE PURPOSE OF IDENTIFYING THE LOCATION OF A WATER RIGHT ONLY AND IS NOT INTENDED TO PROVIDE LEGAL DIMENSIONS OR LOCATION OF PROPERTY OWNERSHIP LINES.

COBU MAP # 0616

0616