

CLAIM OF BENEFICIAL USE MAP



FOR: YVAN LEBEL
BY: NATHAN R. REED, CWRE
T28S, R5W, W.M. SECTION 22
APPLICATION NO. S-86991
PERMIT NO. S-54464

RECEIVED

DEC 02 2011

WATER RESOURCES DEPT
SALEM OREGON

DATE SURVEYED: SEPTEMBER 12, 2011

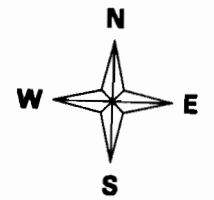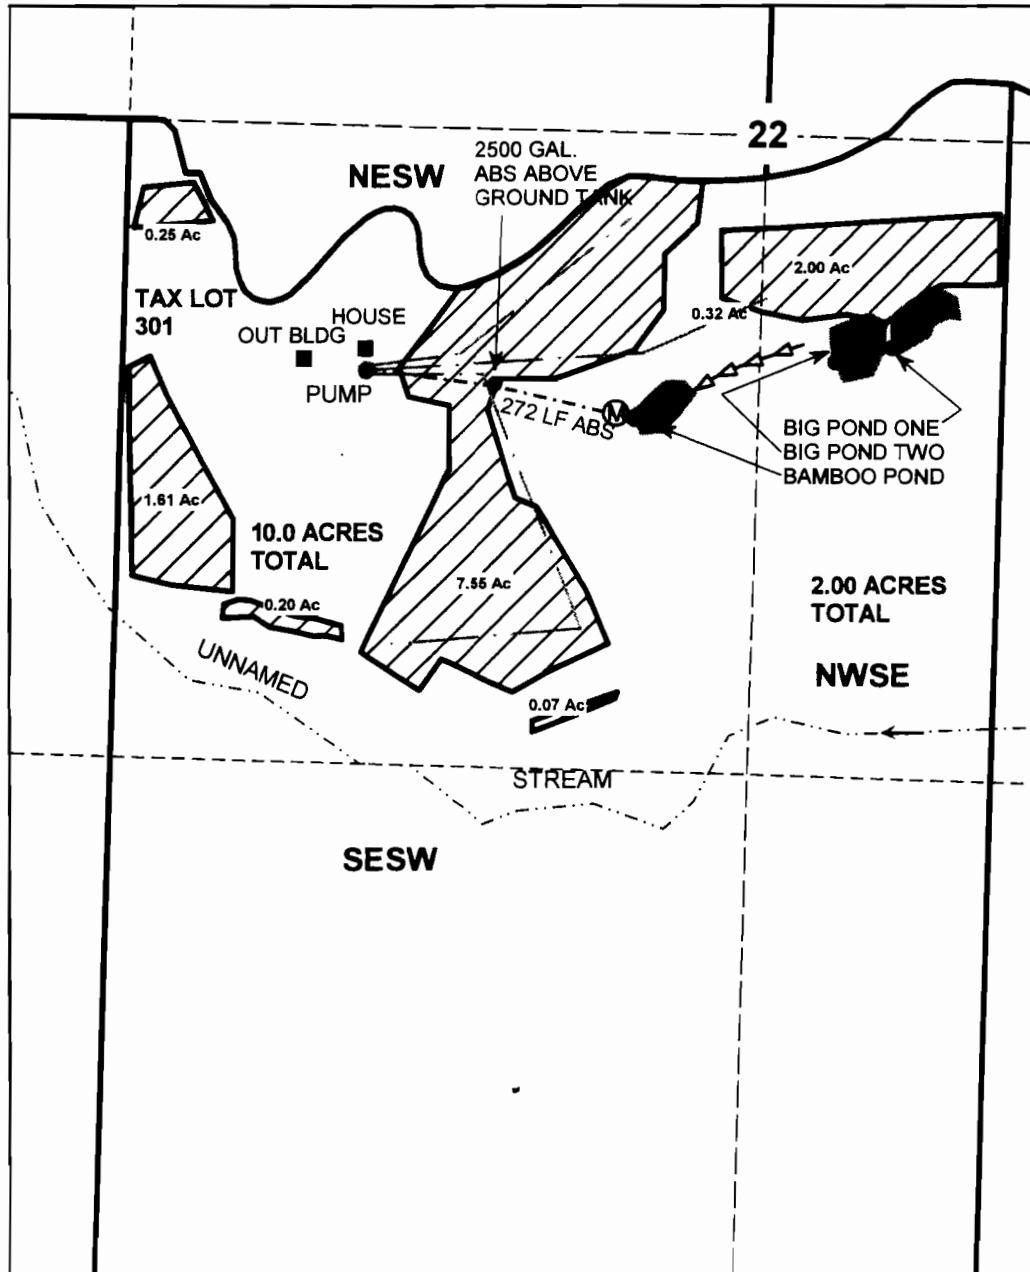

Scale: 1" = 400'

Legend

- POD
- Pond
- Pipeline
- ▨ Irrigation_Area
- structure
- Stream
- Flow_arrow
- Section
- Quarter
- Sixteenth
- Parcels
- ←←←← Ditch
- Distribution Line

BIG POND ONE (R-13553) (CERTIFICATE 83715): 445 FEET SOUTH AND 275 FEET EAST FROM C1/4 CORNER SECTION 22. 1.5 AF
BIG POND TWO (R-13554) (CERTIFICATE 83716): 480 FEET SOUTH AND 150 FEET EAST FROM C1/4 CORNER SECTION 22. 1.0 AF
BAMBOO POND (R-13555) (CERTIFICATE 83707): 600 FEET SOUTH AND 270 FEET WEST FROM C1/4 CORNER SECTION 22. 1.0 AF

THE PURPOSE OF THIS MAP IS TO IDENTIFY THE LOCATION OF THE WATER RIGHT. IT IS NOT INTENDED TO PROVIDE INFORMATION RELATIVE TO THE LOCATION OF PROPERTY OWNERSHIP BOUNDARY LINES.

