


T14.5 R15 E WM

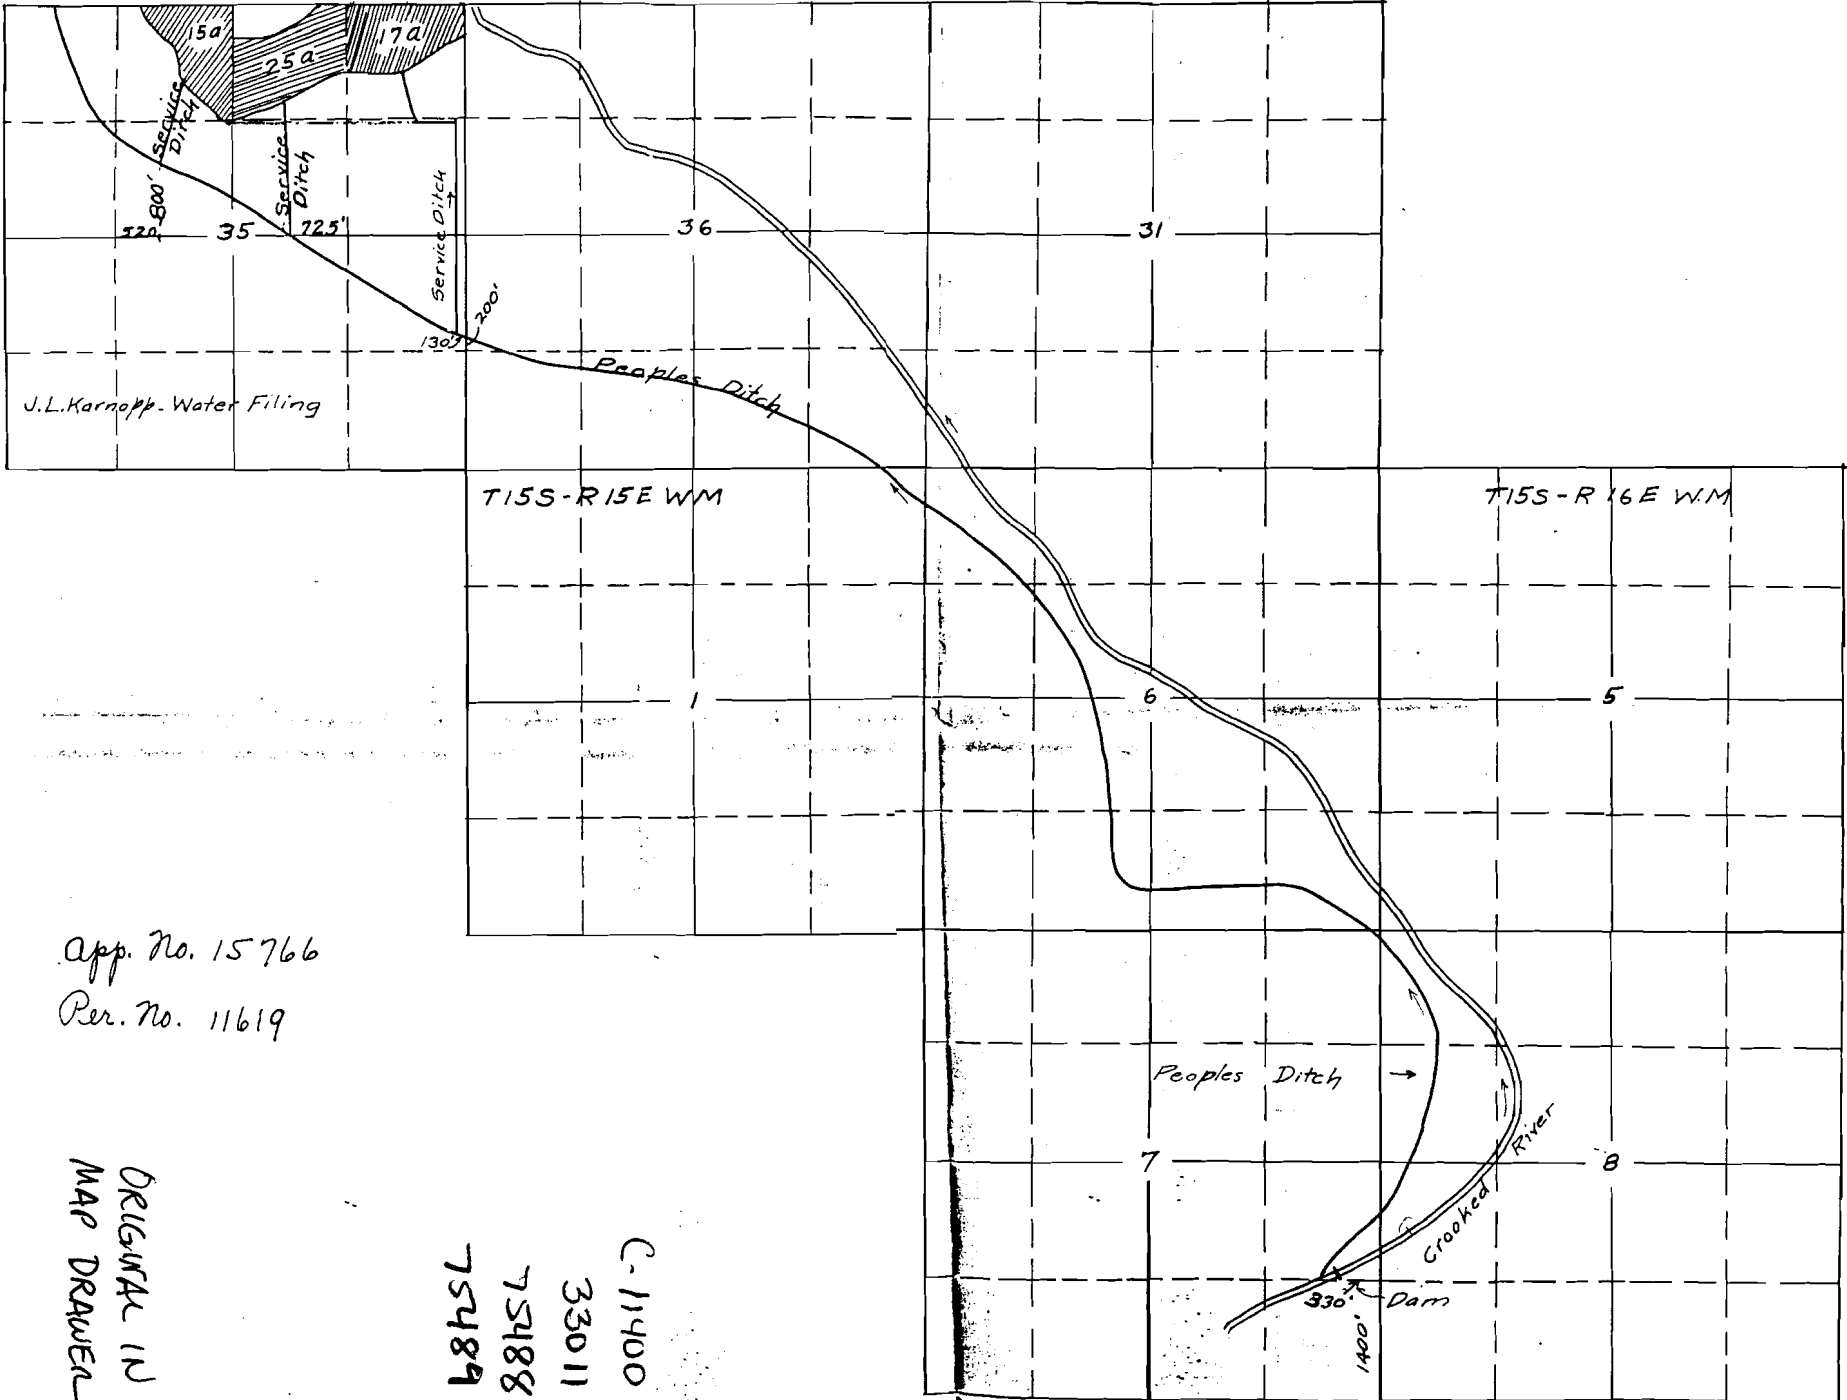

App. No. 15766
Per. No. 11619

ORIGINAL IN
MAP DRAWER

C-11400
33011
75488
75489

15766