


RECEIVED

NW1/4 SEC. 26 T.14S. R.10E.W.M.
DESCHUTES COUNTY

NE1/4 SEC. 26 T.14S. R.10E. W.M.
DESCHUTES COUNTY

WATER RESOURCES DEPT
SALEM, OREGON

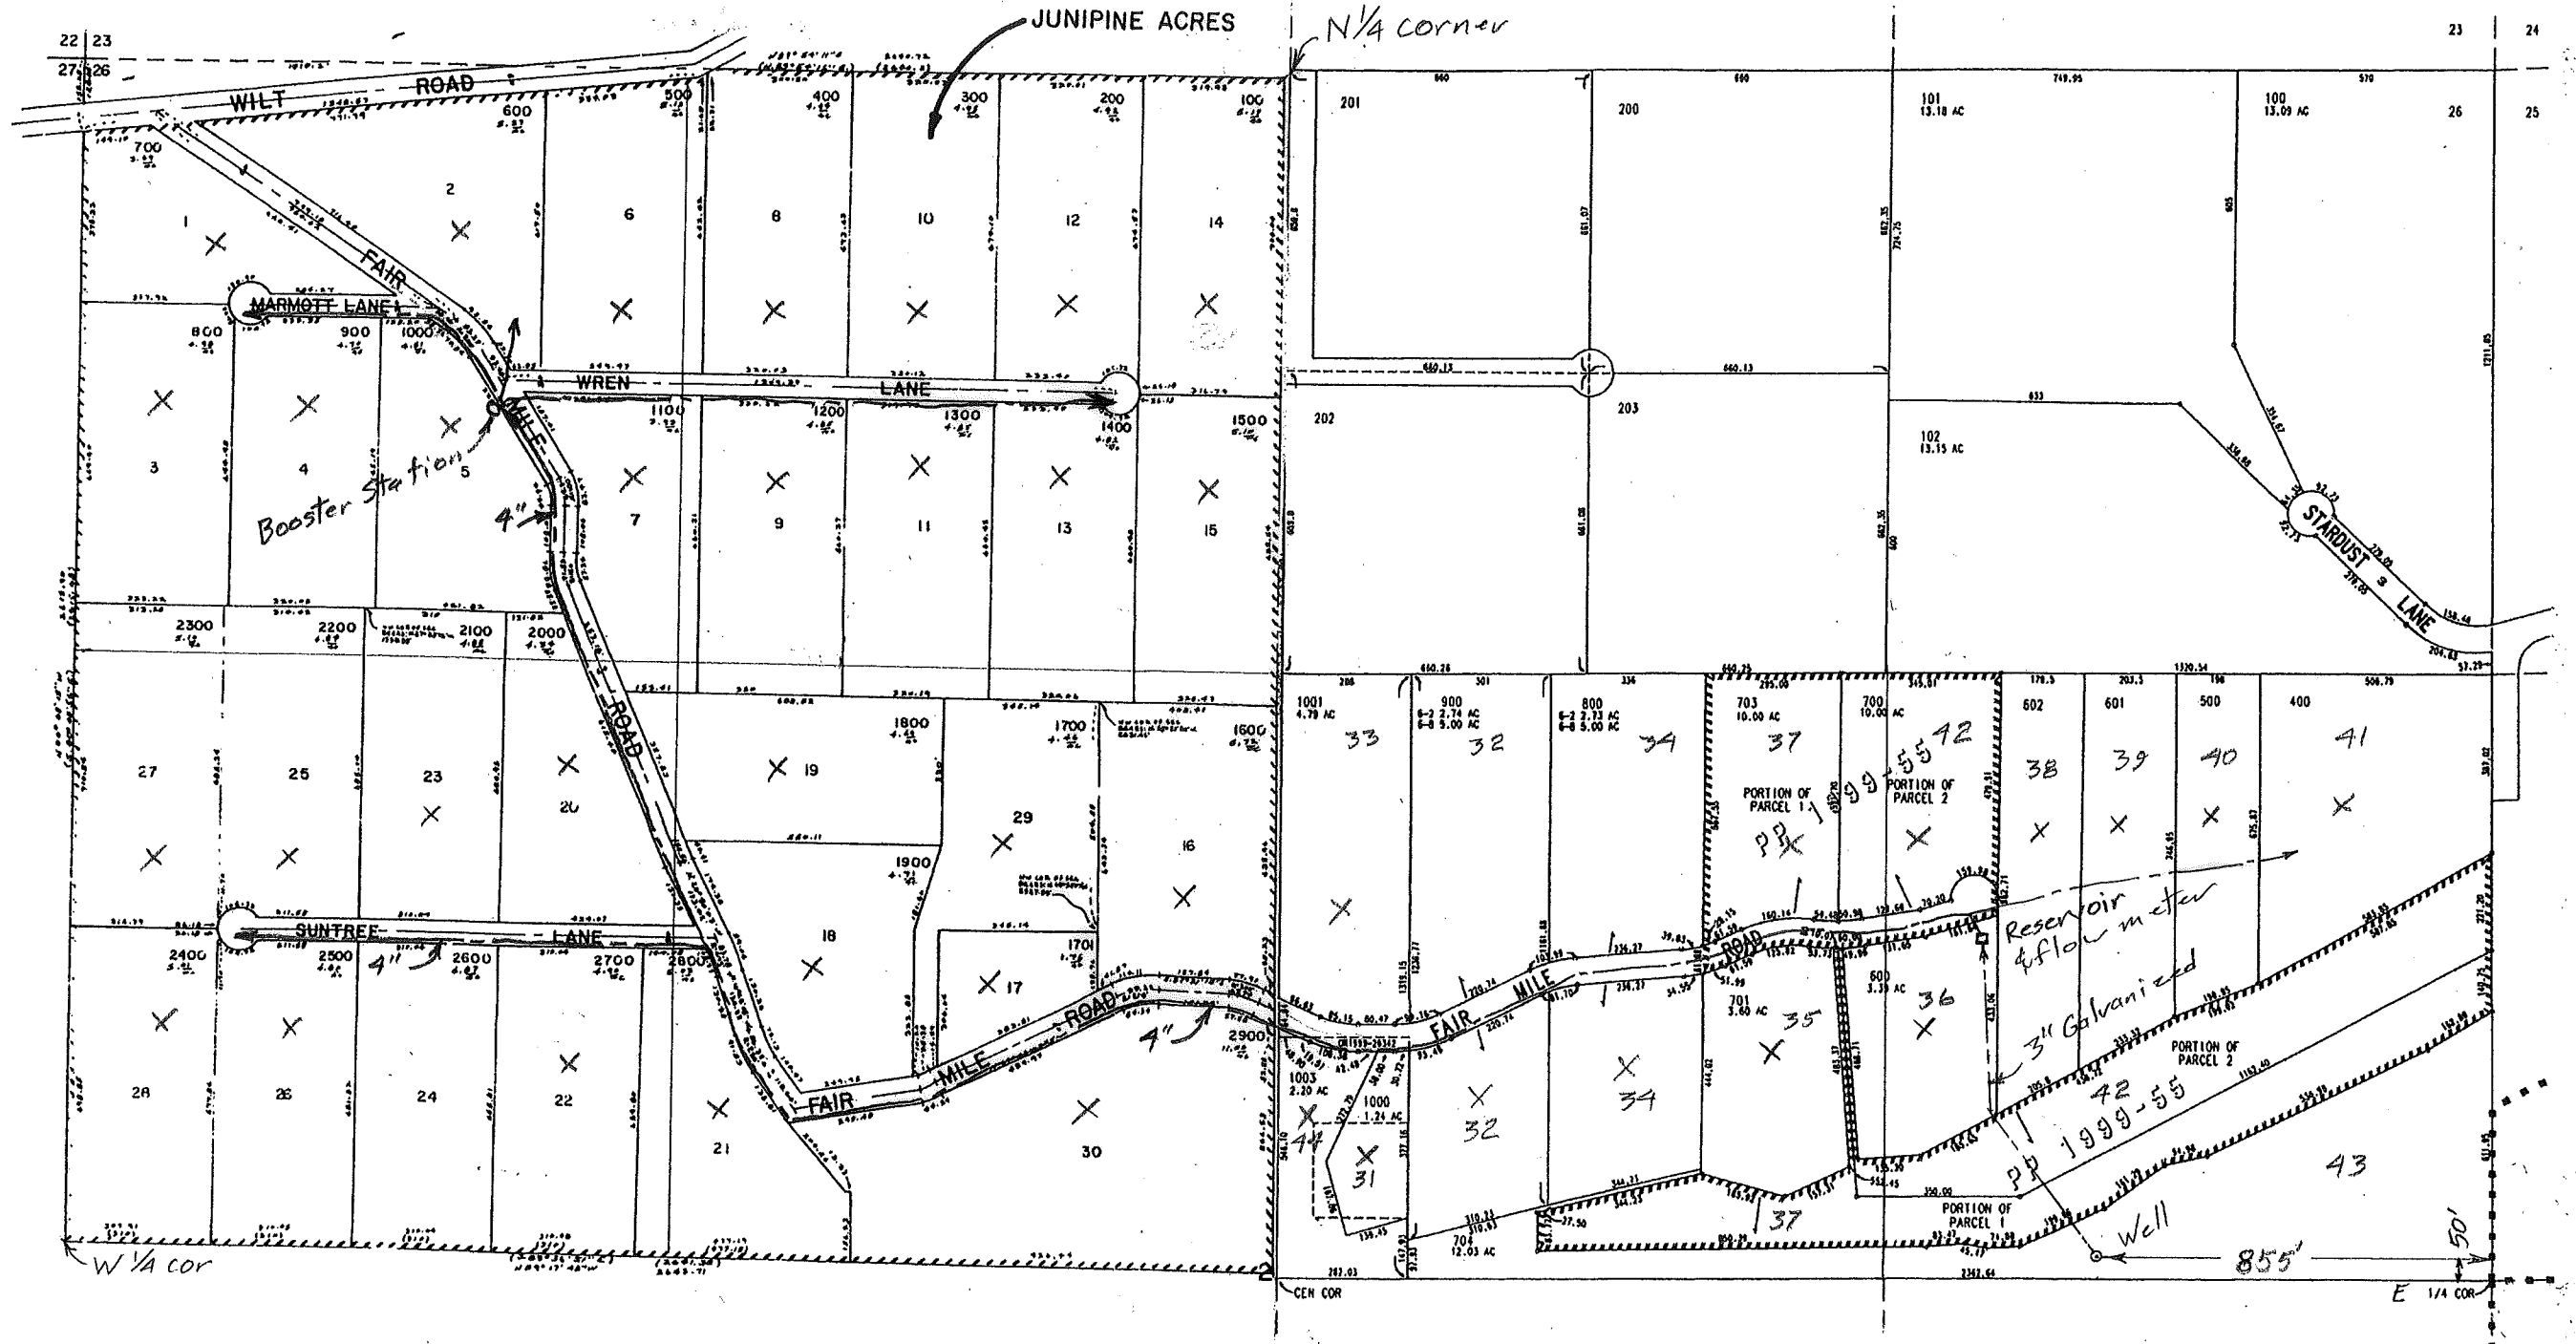


Scale 1" = 400'

42 lots

T-10296

Claim of Beneficial Use Map
for
JUNIPINE HOME OWNERS ASSOCIATION

This map is for the purpose of
locating a water right only
and has no intent to provide
legal dimensions or the location
of property lines.

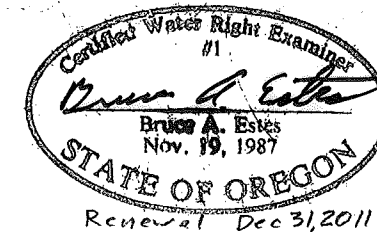

ESTES SURVEYS, LLC
 PO Box 17549 60382 Arnold Rd
 Salem, OR 97305-7549 Bend, OR 97702
 (503) 565-7593 (503) 382-7391