


TOWNSHIP 14 SOUTH, RANGE 11 EAST, W.M.

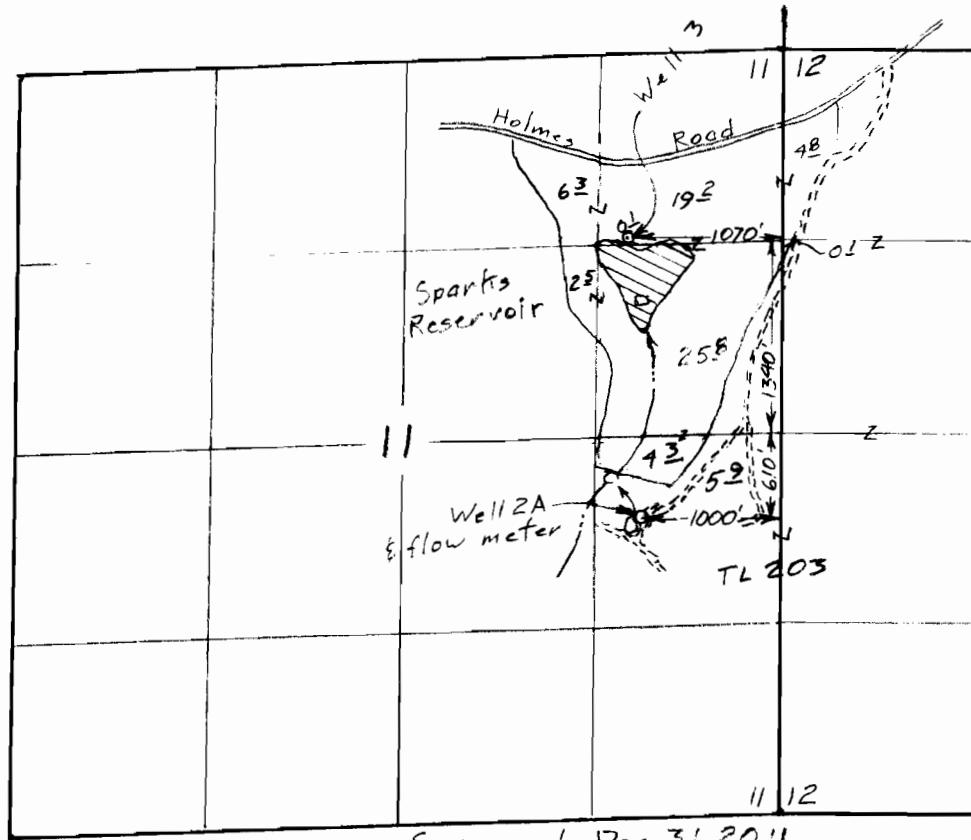


Scale  
1" = 1320'  
(4" = 1 mile)

Surveyed Dec 31, 2011

- C-84174 63<sup>±</sup> acres
- ◐ T-10296 Reservoir Storage & Maintenance

Claim of Beneficial Use Map  
for  
STEPHEN M. SPARKS REVOCABLE TRUST

Transfer T-10296

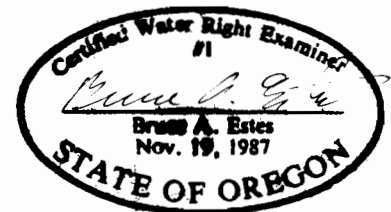

Renewal Dec 31, 2013

This map is for the purpose of locating a water right only and has no intent to provide legal dimensions or the location of property lines.

**ESTES SURVEYS, LLC**  
 PO Box 17519 60382 Arnold Rd  
 Salem, OR 97306-7519 Bend, OR 97702  
 (503) 685-7693 (541) 382-7391