

T.1S., R.4E., W.M.
SECTION 29

CENTER SECTION

1/4 CORNER

WAYBILL RD. 3

WELL POINT →
6" MAIN →


5" MAIN →
THE WELL IS
520' SOUTH
AND
73' WEST
OF THE
C 1/4 CORNER.

ACCESS ROAD 2

4" RISER

TAX LOT
1400
9.0 AC.

□ GAR. No.

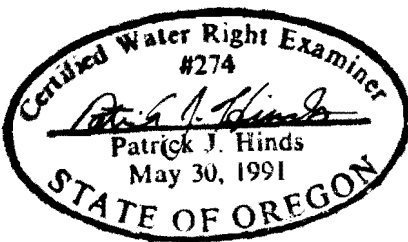

6' DITCH

ORIENT DR. 2

30 29

HALEY RD. 2

31 32

SCALE 1"=400' BASIS OF BEARING P.S. # 13956

RECEIVED

FINAL PROOF SURVEY
UNDER

APPLICATION # G-13495 PERMIT # G-11795
IN THE NAME OF
DAN L. NELSON

SURVEYED DEC. 2, 1995 By PATRICK J. HINDS