


TOWNSHIP 2 SOUTH, RANGE 2 EAST, W. M.

RECEIVED

SEP 26 1996

WATER RESOURCES DEPT
DIFM OREGON

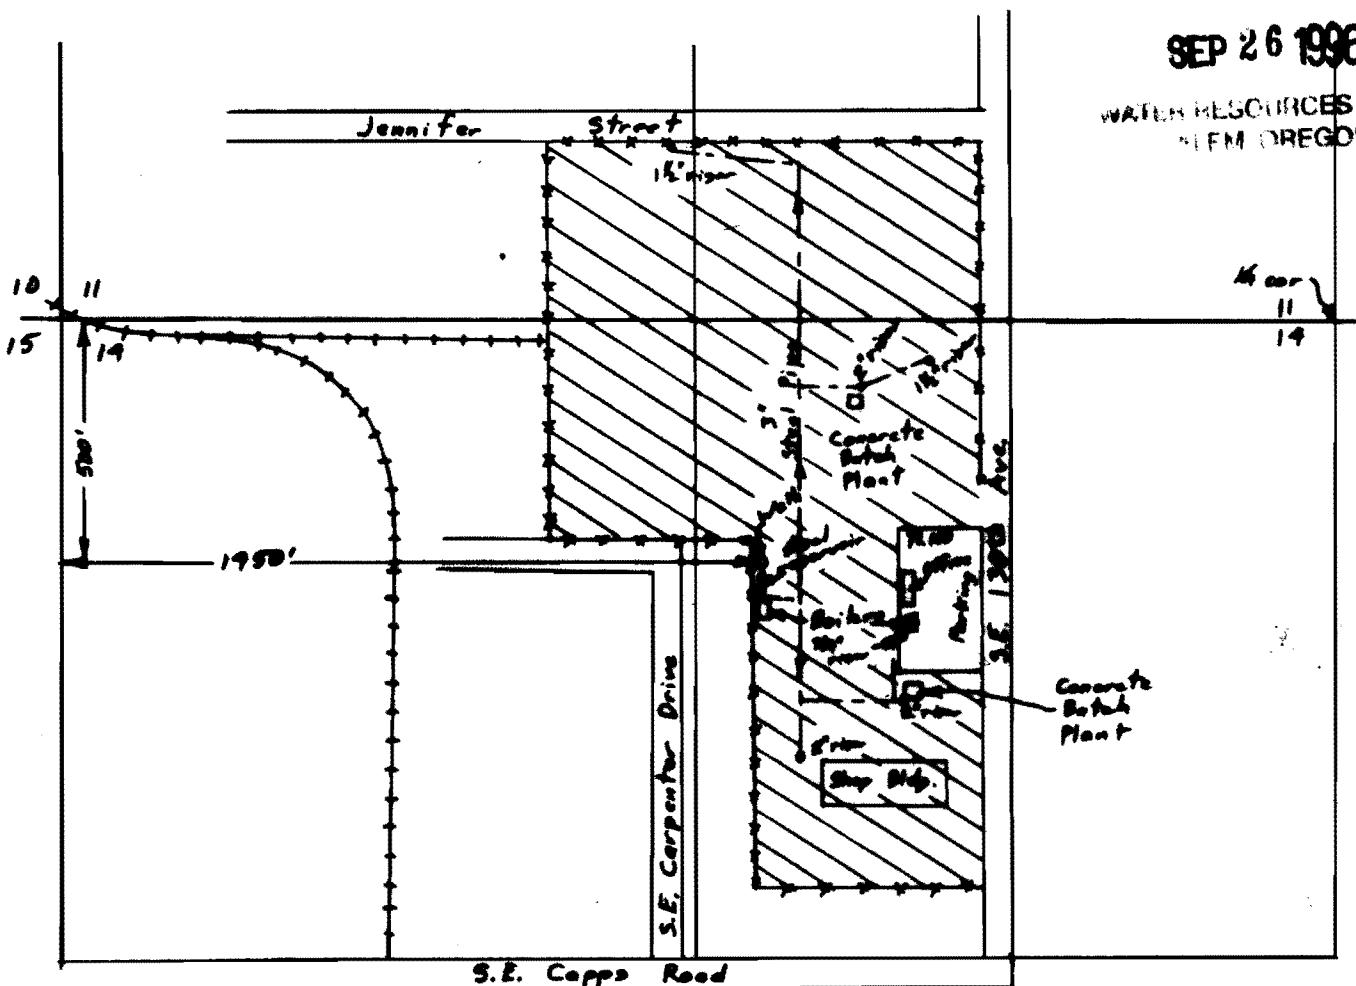

Scale 1" = 400'


Surveyed Sept. 23, 1996

Claim of Beneficial Use Map
for

MORSE BROS., INC.

Application G-12676

Permit G-11458

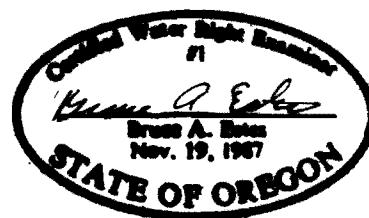

This map is for the purpose of locating a water right only and has no intent to provide legal dimensions or the location of property lines.

ESTES SURVEYS

6283 Sunnyview Rd. NE 60382 Arnold Rd.
Salem, OR 97305 Bend, OR 97702
(503) 585-7593 (503) 382-7391