



T. 7 S., R. 2 W., W.M.

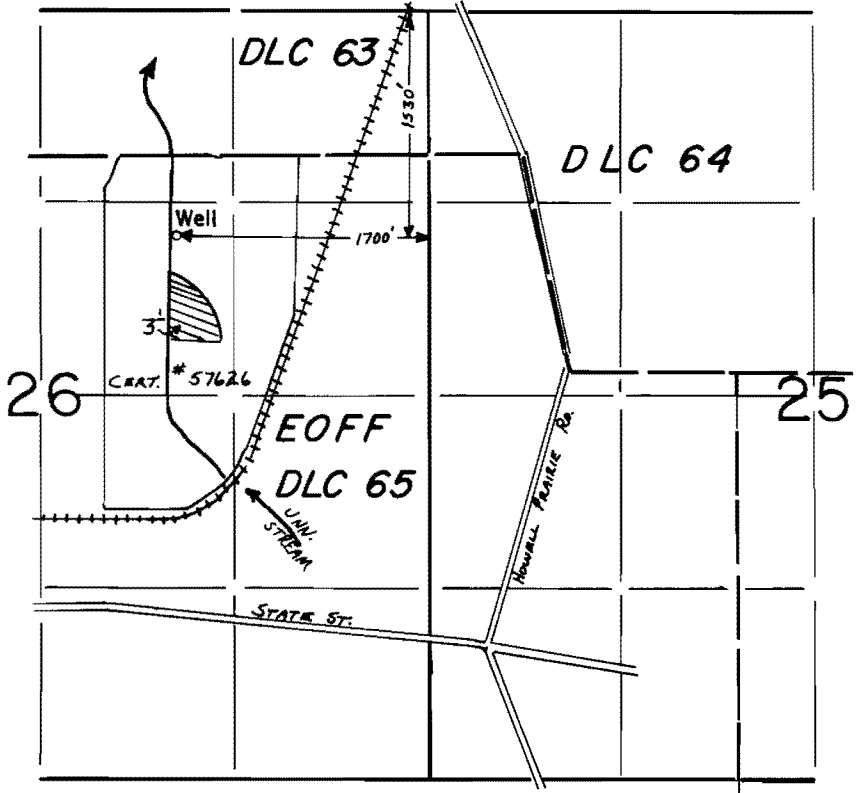

THIS MAP WAS PREPARED SOLELY FOR THE PURPOSE OF DEPICTING THE LOCATION OF A WATER RIGHT, AND HAS NO INTENTION OF BEING USED TO DETERMINE REAL PROPERTY BOUNDARIES.

Scale: 1" = 1320'

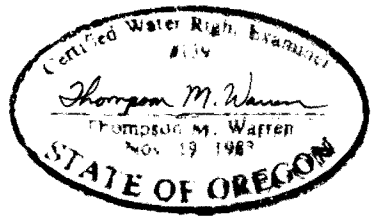

FINAL PROOF SURVEY

Application No. G-13528 Permit No. G-11868

in name of

GARY L. KAUFMAN

Surveyed June 14, 1996

RECEIVED

JUN 18 1996

WATER RESOURCES DEPT
SALEM OREGON

ASCS
PHOTO
DFN-6LL-210