


G-2684
37821

T.41S.R.10E.W.M.

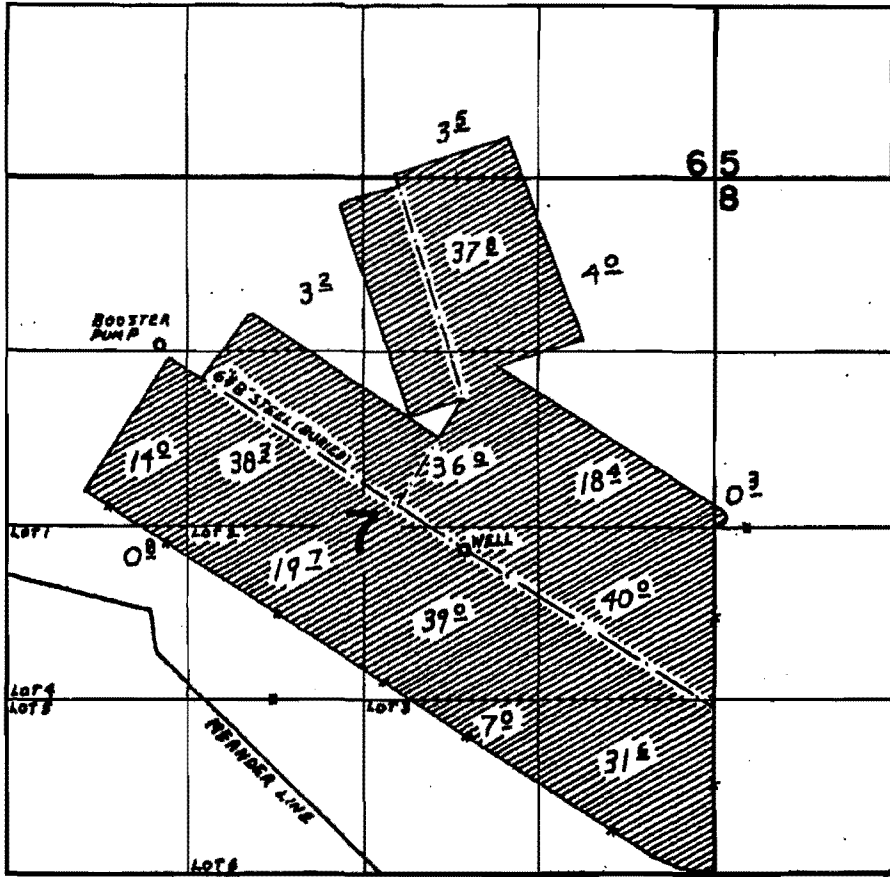

WELL LOC. 160' S. & 1870' W. FROM E. 1/4 COR. SEC. 7

East Rv. Wells

FINAL PROOF SURVEY

UNDER

Application No. G-2902 Permit No. G-2684

IN NAME OF

O'CONNOR LIVESTOCK COMPANY

Surveyed OCT. 27, 19.70., by G. BACA

T 11286

RECEIVED
AUG 29 2011
WATER RESOURCES DEPT
SALEM, OREGON