


Pr# 9387
8756

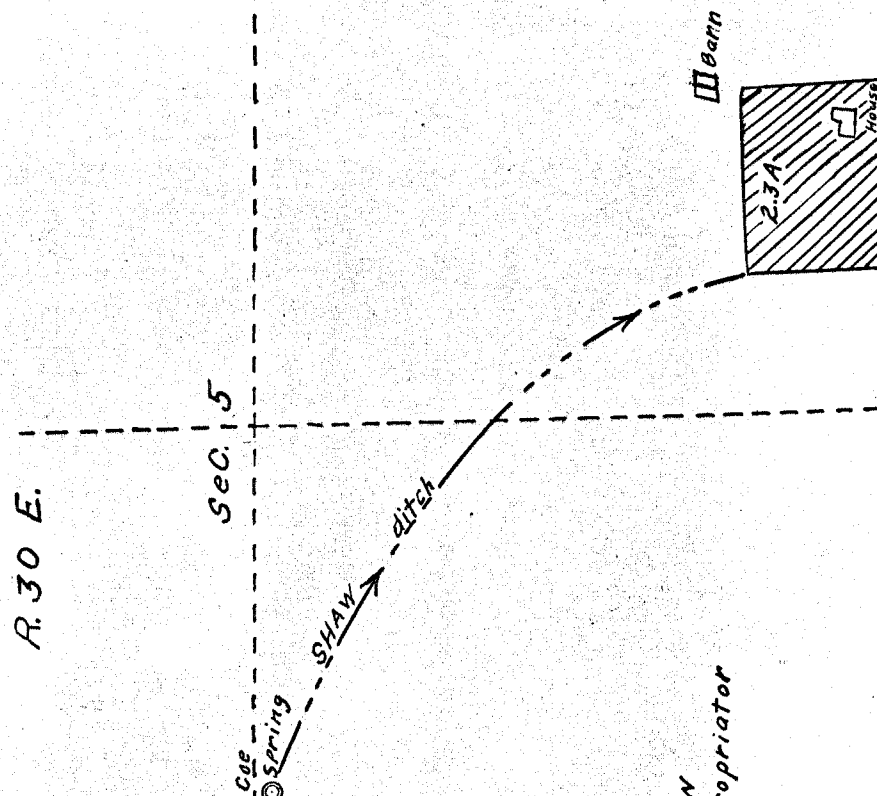

Application No. 13132 ^{Plot of} SHAW DITCH. R.W. SHAW
Permit No. 9387

R. W. Shaw
Appropriator
Scale 1 in. = 400 ft.

588°17'E 1950 ft.

T. 10 S.
W. 1/4
sec 5

P. 30 E.

sec. 5

Plot of
SHAW DITCH

Scale 1 in. = 400 ft.