


T. 27S., R. 6W., W.M.

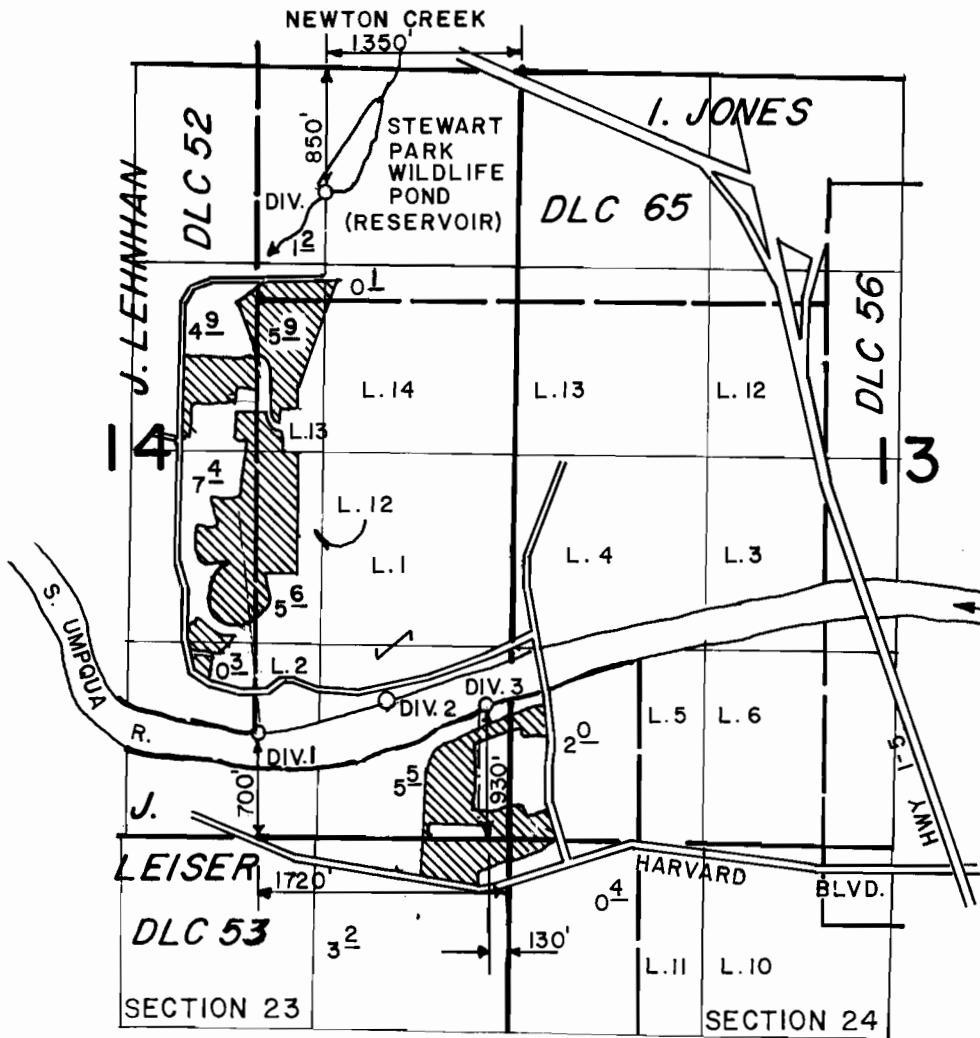

**FINAL PROOF SURVEY**  
UNDER

R-31836                      R-2119  
31837                      25405  
Application No. 60117..... Permit No. 45076.....  
IN NAME OF

.....**THE CITY OF ROSEBURG**.....

Surveyed NOV. 5..... 1987., by J. M. SCHMORDE.