



T.9S. R.40E. W.M.

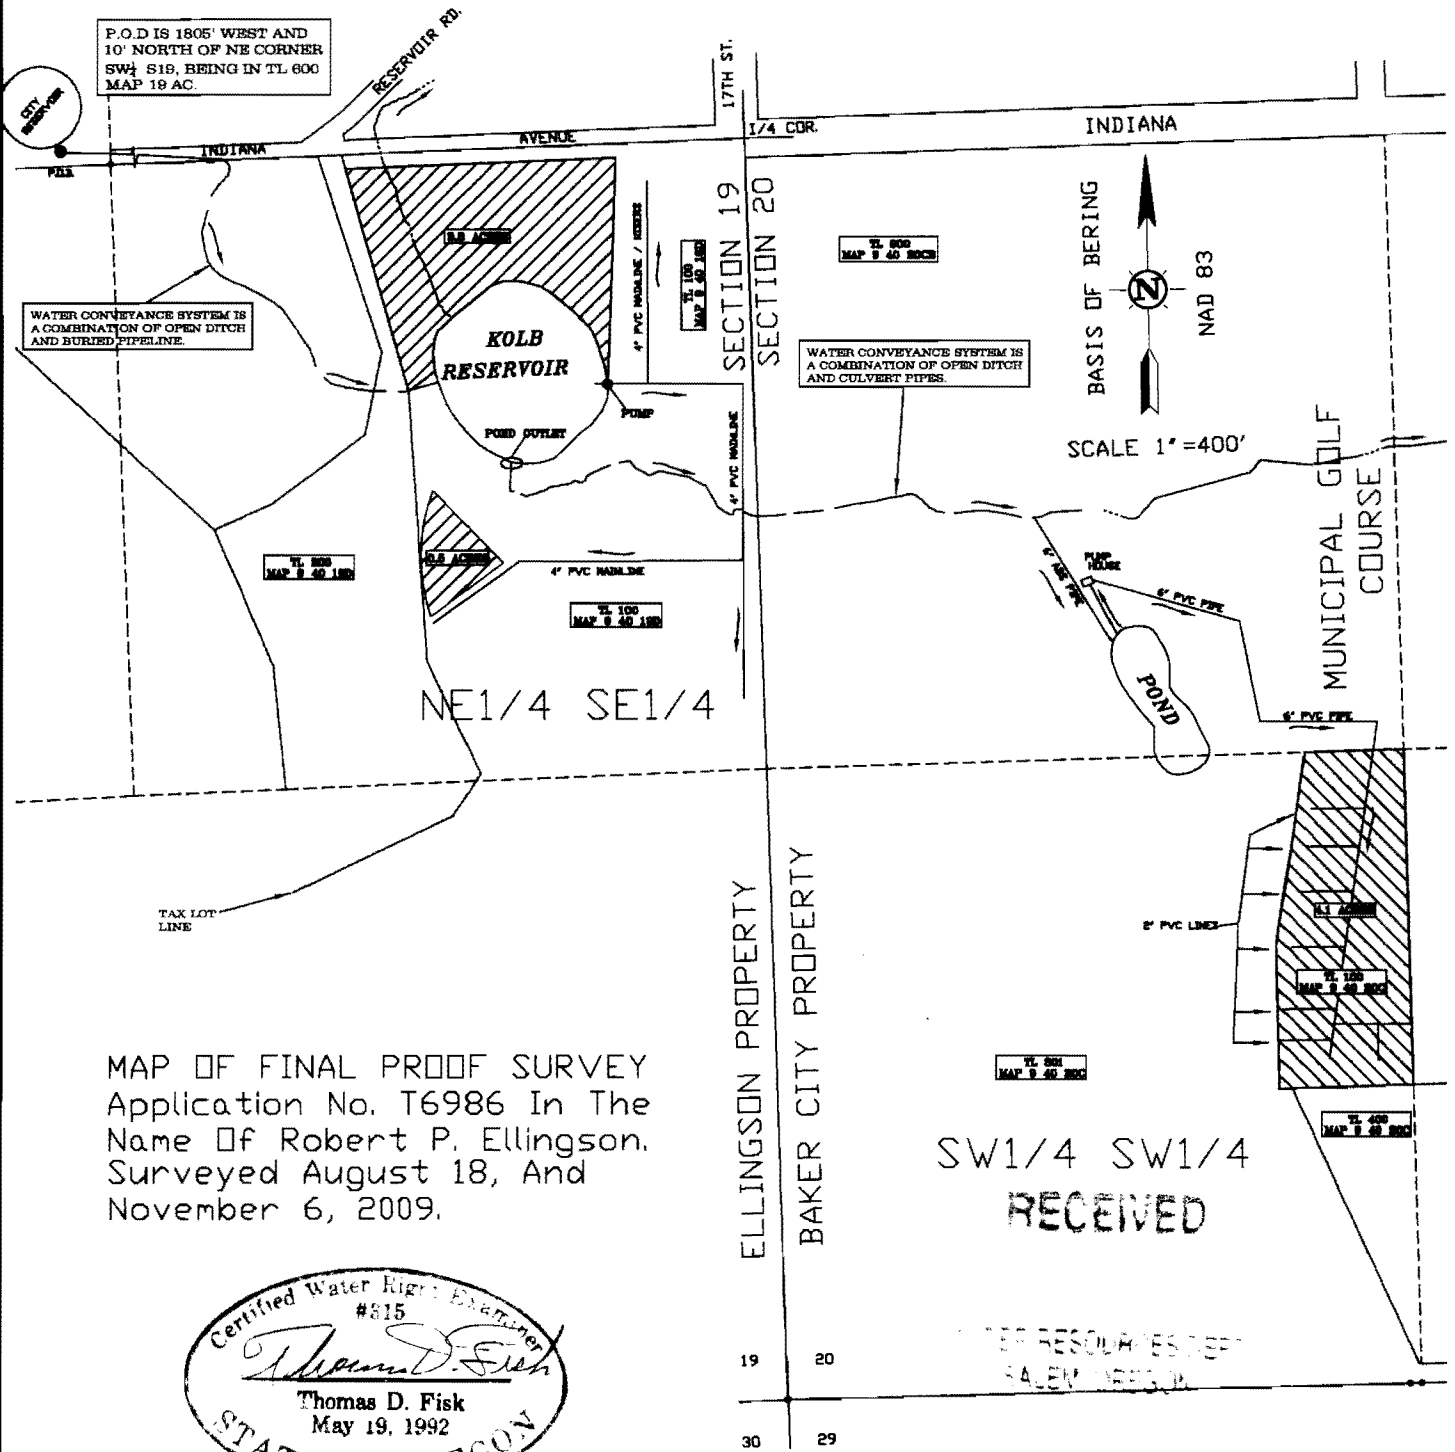

MAP OF FINAL PROOF SURVEY
 Application No. T6986 In The
 Name of Robert P. Ellingson,
 Surveyed August 18, And
 November 6, 2009.

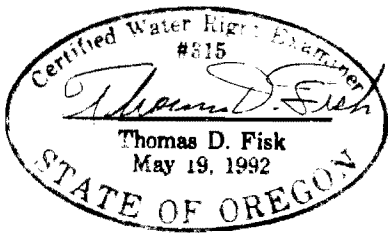

SW1/4 SW1/4
RECEIVED

THIS MAP WAS PREPARED FOR THE PURPOSE OF IDENTIFYING THE LOCATION OF A WATER RIGHT ONLY AND IS NOT INTENDED TO PROVIDE LEGAL DIMENSIONS OR LOCATION OF PROPERTY OWNERSHIP LINES.