
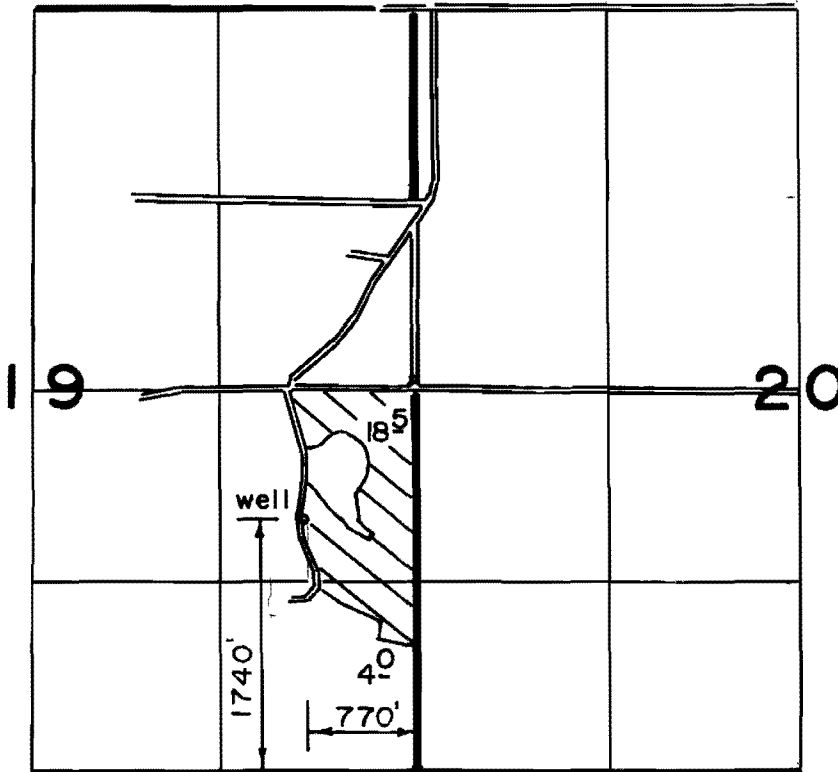


T. 9S R. 40E., W.M.

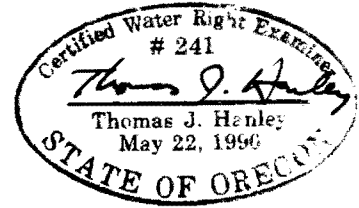

SCALE 1" = 1320'

THE PURPOSE OF THIS MAP IS FOR IDENTIFYING THE LOCATION OF THE WATER RIGHT ONLY AND IS NOT INTENDED TO PROVIDE LEGAL DIMENSIONS OF PROPERTY OWNERSHIP LINES.

FINAL PROOF SURVEY

UNDER

APPL. G-13418

PER. G-12088

IN NAME OF

ROBERT P. ELLINGSON III

Surveyed June 2, 1999

RECEIVED

SEP 30 1999

WATER RESOURCES DEPT.
SALEM, OREGON