



T. 9 S., R. 40 E., W.M.

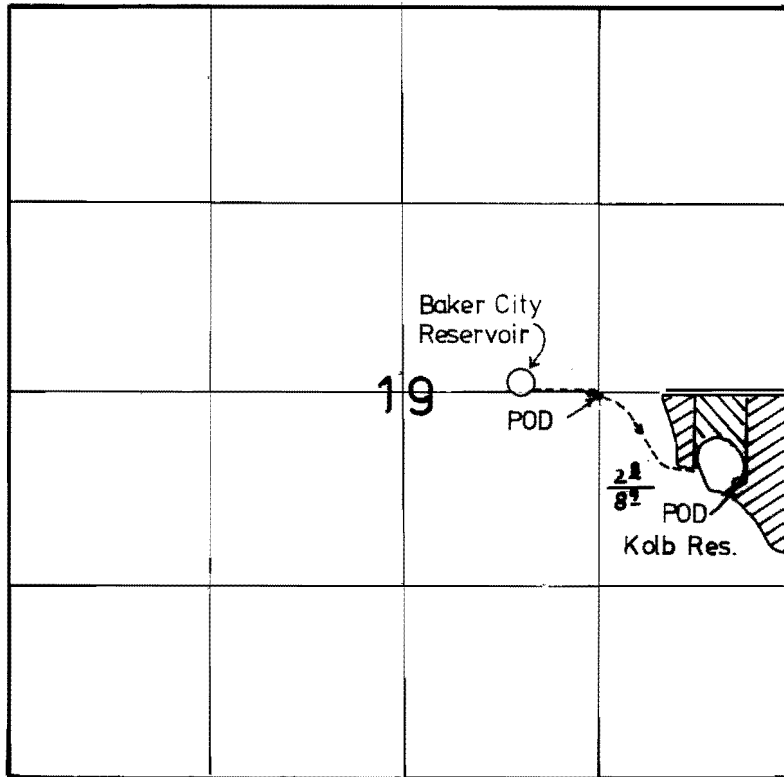

POD 1- 5' South & 1300' West

POD 2- 620' South & 350' West

Both being from the E. 1/4 COR. SEC.19

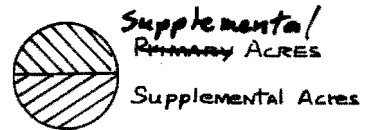

FINAL PROOF SURVEY

UNDER

Application No. R-61086 Permit No. R 8297
 61087 45920

IN NAME OF

ROBERT P. ELLINGSON III

Surveyed 8-6, 1990, by K. KEMP

2-9-2012 HC
4-30-94 JM BBB-3KK-162