


CLAIM OF BENEFICIAL USE MAP

FOR

CHARLES K. KELLEY


SECTIONS 7, 17 & 18
TOWNSHIP 39 SOUTH RANGE 19 EAST,
LAKE COUNTY, OREGON

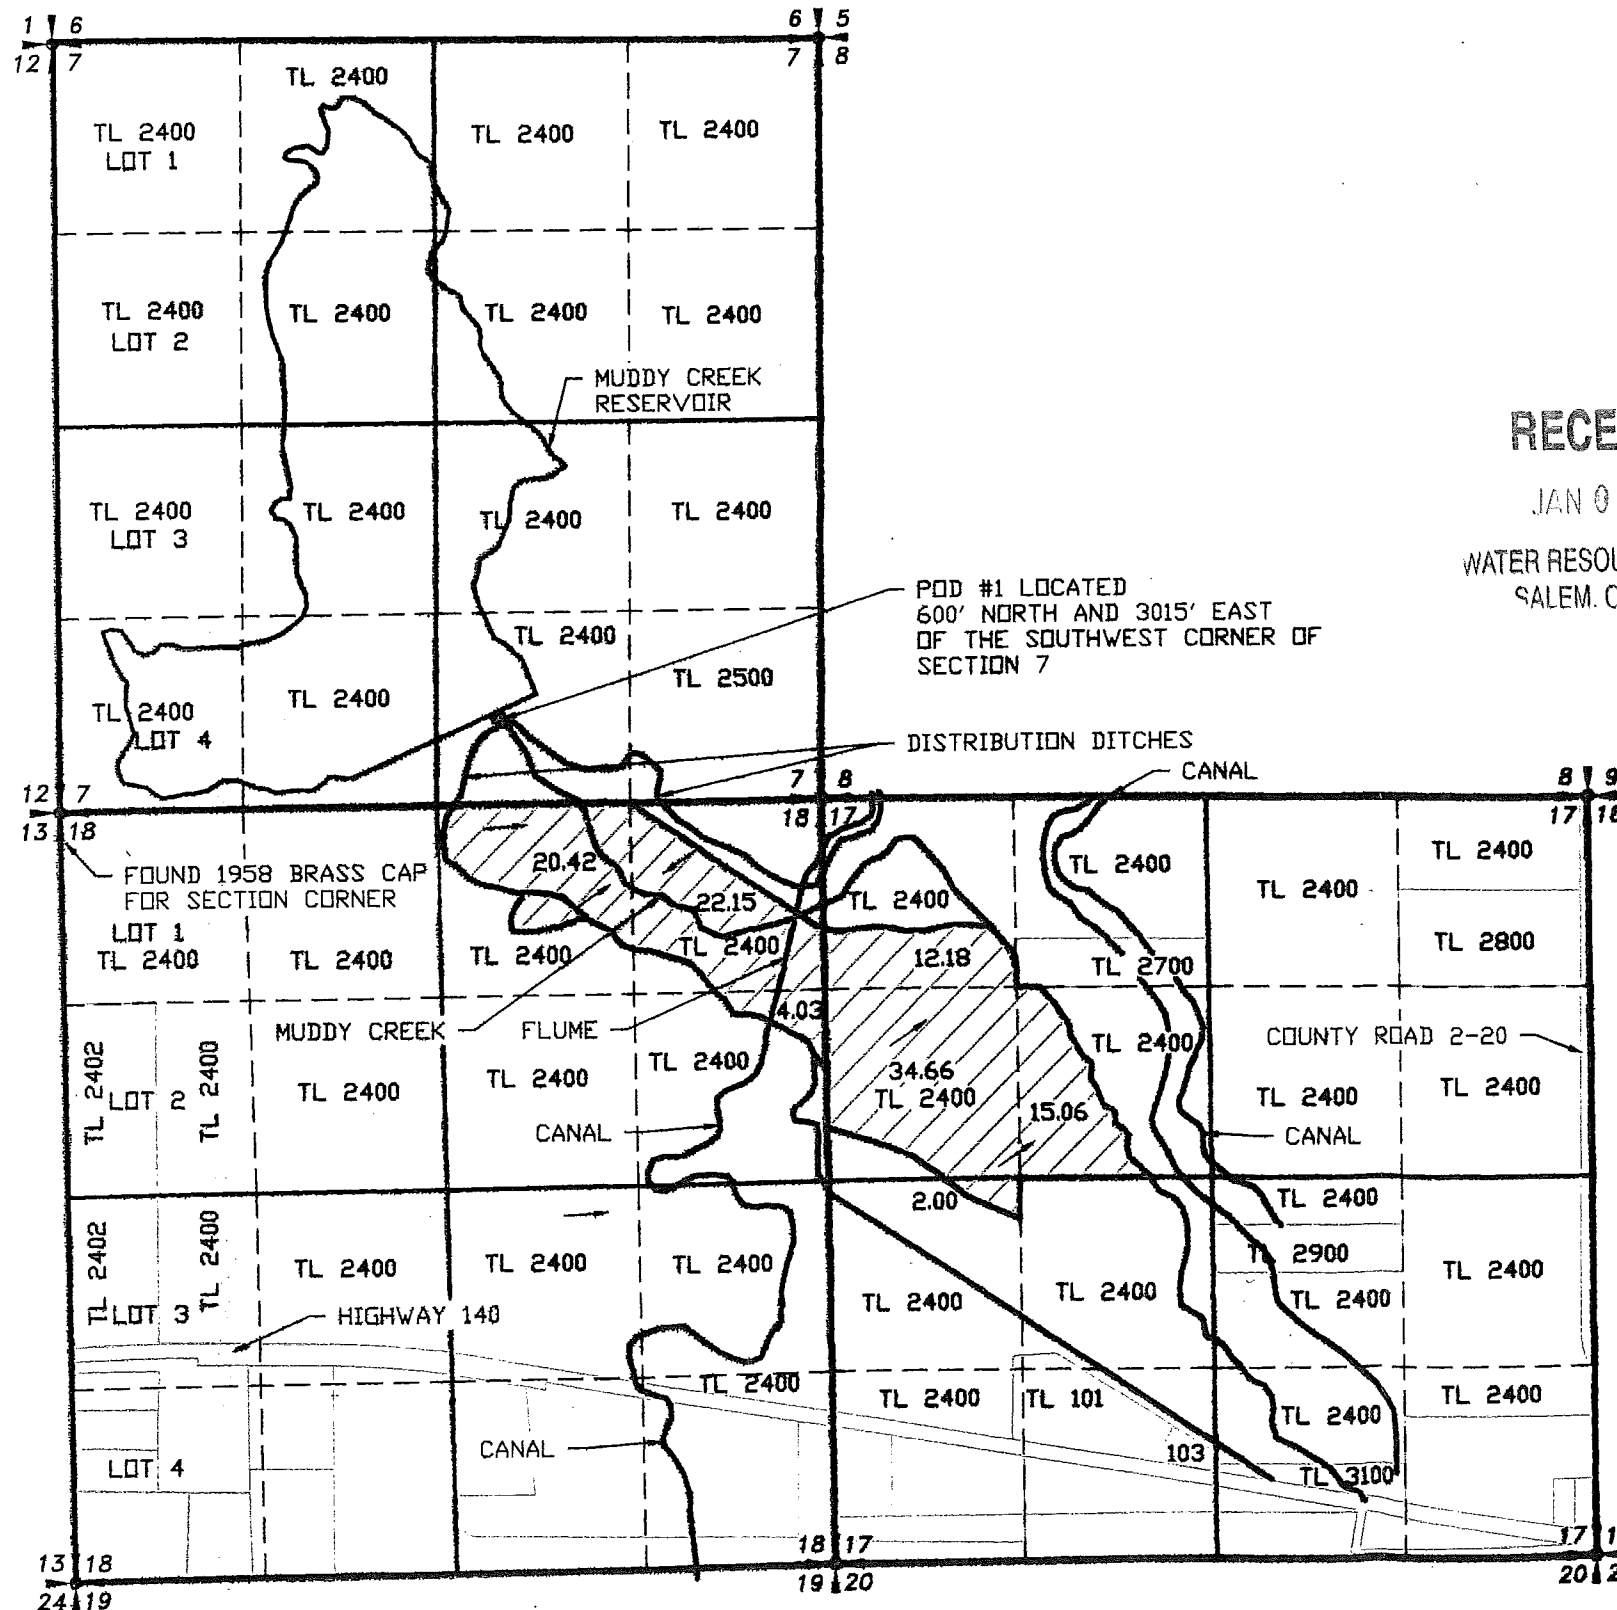

RECEIVED

JAN 06 2012

WATER RESOURCES DEPT
SALEM, OREGON

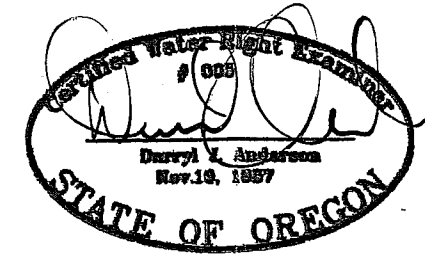

RENEWAL 12/31/13

LEGEND

- SECTION LINE
- 1/4 SECTION LINE
- 1/16 SECTION LINE
- IRRIGATION MAIN LINE
- DISTRIBUTION DITCH
- DIRECTION OF FLOW



SCALE: 1"=1320'

APPLICATION NO. S-68690

PERMIT NO. S-49825

NOTE:
PREPARATION OF THIS MAP IS FOR IDENTIFYING PROPOSED
WATER RIGHTS ONLY. IT HAS NO INTENT TO PROVIDE
LOCATIONS OR DIMENSIONS OF PROPERTY BOUNDARIES.

CORI MAP # 0645

REVISION	BY

ANDERSON ENGINEERING
AND SURVEYING, INC.
P.O. BOX 28
LAKEVIEW, OREGON 97630
(541) 947-4407
FAX 947-2321

FOR: CHARLES K. KELLEY
P.O. BOX 711
LAKEVIEW, OR 97630
541-947-3000

CLAIM OF BENEFICIAL USE MAP
APPLICATION NO. S-68690
PERMIT NO. S-49825

DATE:	11/02/11
SCALE:	1"=1320'
DWG. BY:	R.C.
JOB:	2011-001
FILE:	S49825
SHEET:	1 OF 1

CLAIM OF BENEFICIAL USE MAP

FOR

CHARLES K. KELLEY

SECTIONS 7, 17 & 18
TOWNSHIP 39 SOUTH RANGE 19 EAST,
LAKE COUNTY, OREGON

RECEIVED

JAN 06 2012

WATER RESOURCES DEPT
SALEM, OREGON



RENEWAL 12/31/13

LEGEND

- SECTION LINE
- 1/4 SECTION LINE
- 1/16 SECTION LINE
- IRRIGATION MAIN LINE
- DISTRIBUTION DITCH
- DIRECTION OF FLOW



PRIMARY IRRIGATION


SCALE: 1"=1320'

APPLICATION NO. S-68690

PERMIT NO. S-49825

NOTE:
PREPARATION OF THIS MAP IS FOR IDENTIFYING PROPOSED
WATER RIGHTS ONLY. IT HAS NO INTENT TO PROVIDE
LOCATIONS OR DIMENSIONS OF PROPERTY BOUNDARIES.

CORI MAP # 0645

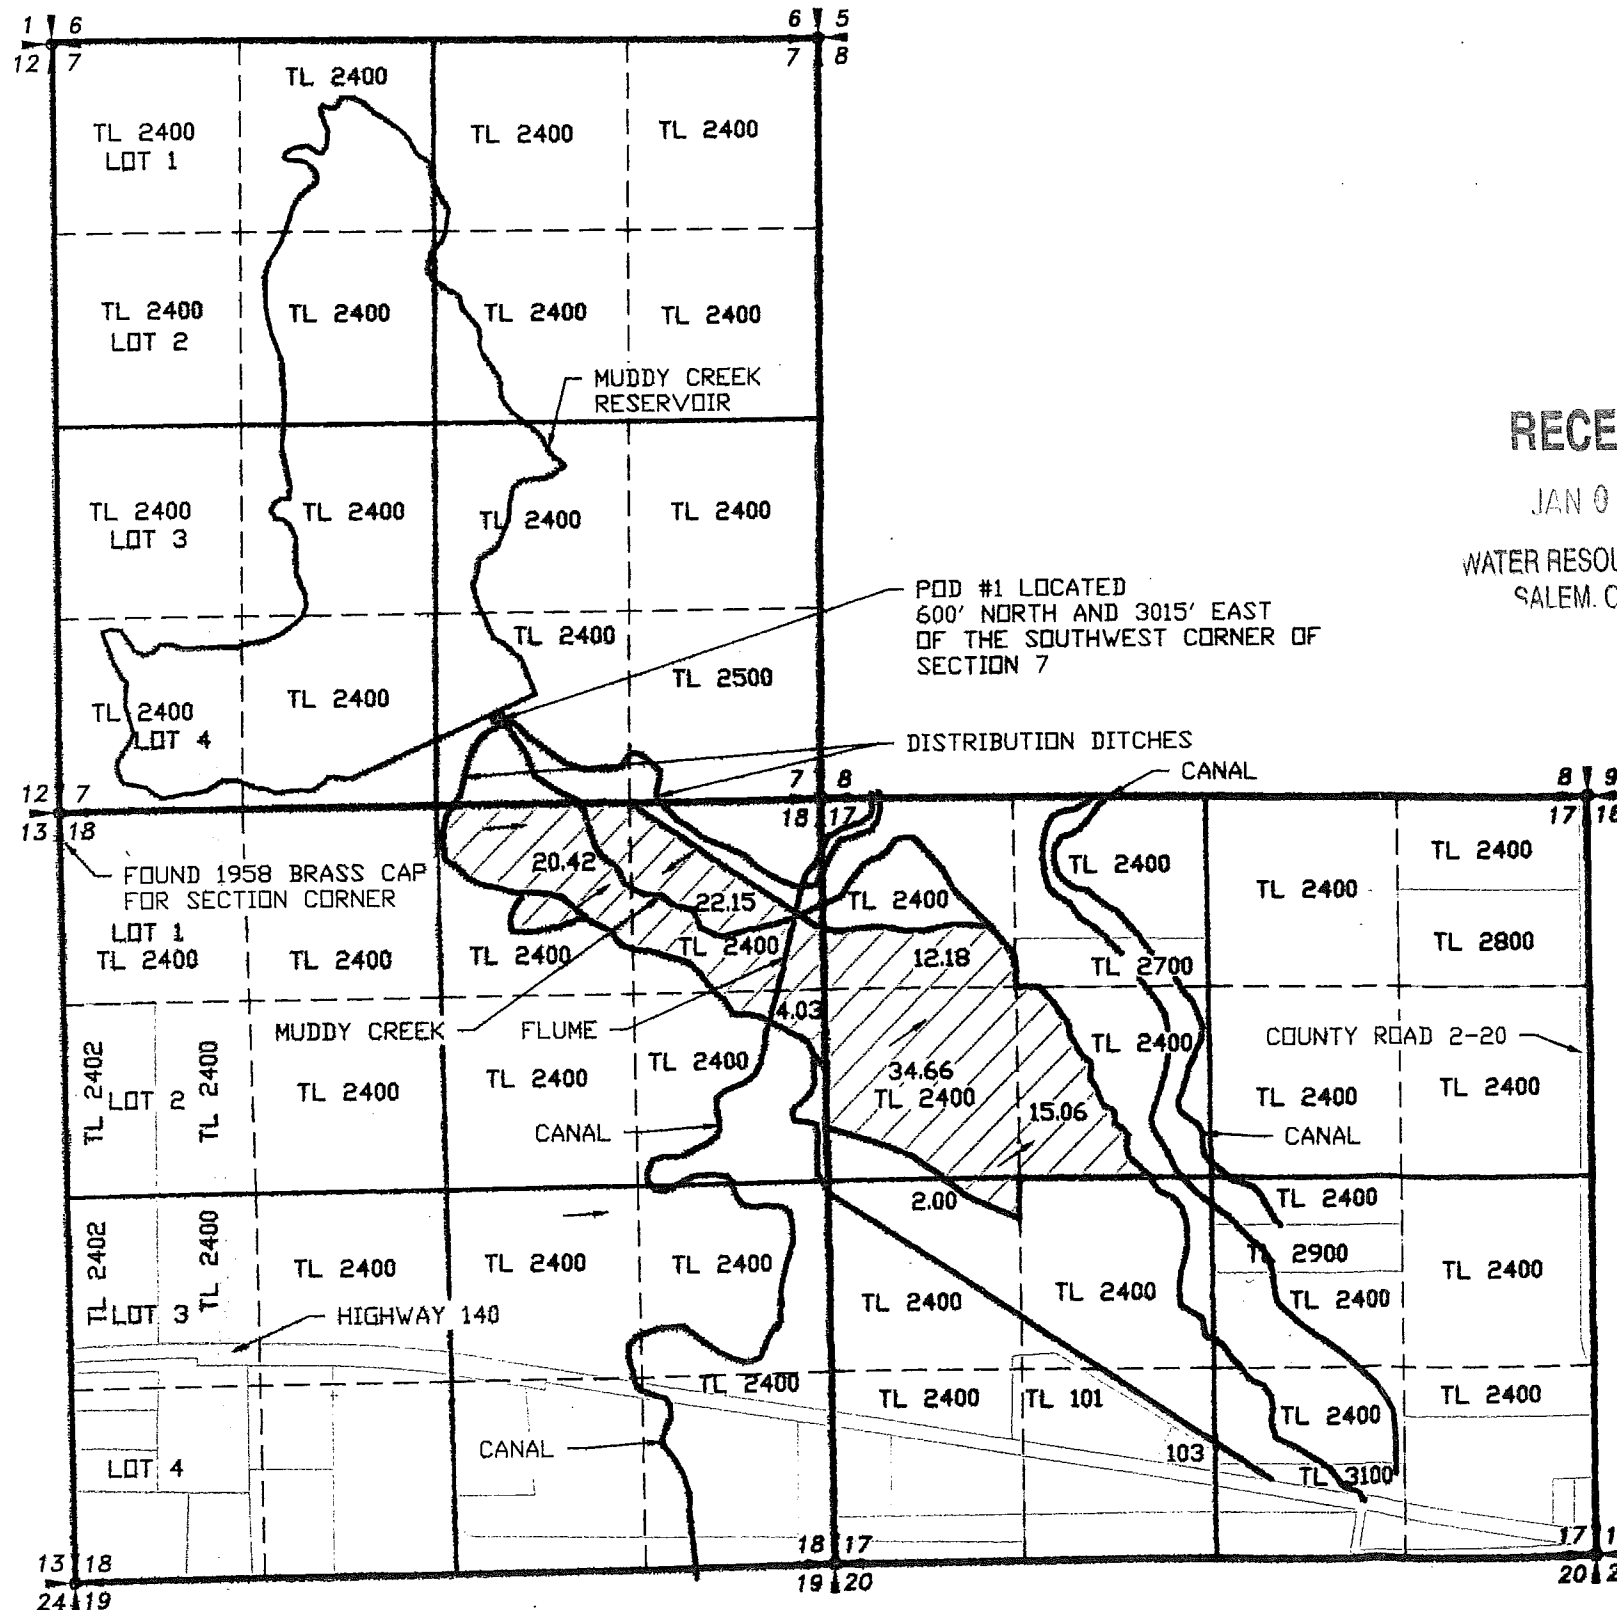

REVISION	BY
ANDERSON ENGINEERING AND SURVEYING, INC. P.O. BOX 28 LAKEVIEW, OREGON 97630 (541) 947-4407 FAX: 947-2321	
FOR: CHARLES K. KELLEY P.O. BOX 711 LAKEVIEW, OR 97630 541-947-3000	
CLAIM OF BENEFICIAL USE MAP APPLICATION NO. S-68690 PERMIT NO. S-49825	
DATE:	11/02/11
SCALE:	1"=1320'
DWG. BY:	R.C.
JOB:	2011-001
FILE:	949825
SHEET:	1 OF 1