

CLAIM OF BENEFICIAL USE MAP


FOR

CHARLES K. KELLEY

SECTION 12, TOWNSHIP 39 SOUTH RANGE 18 EAST

SECTION 7, TOWNSHIP 39 SOUTH RANGE 19 EAST


LAKE COUNTY, OREGON

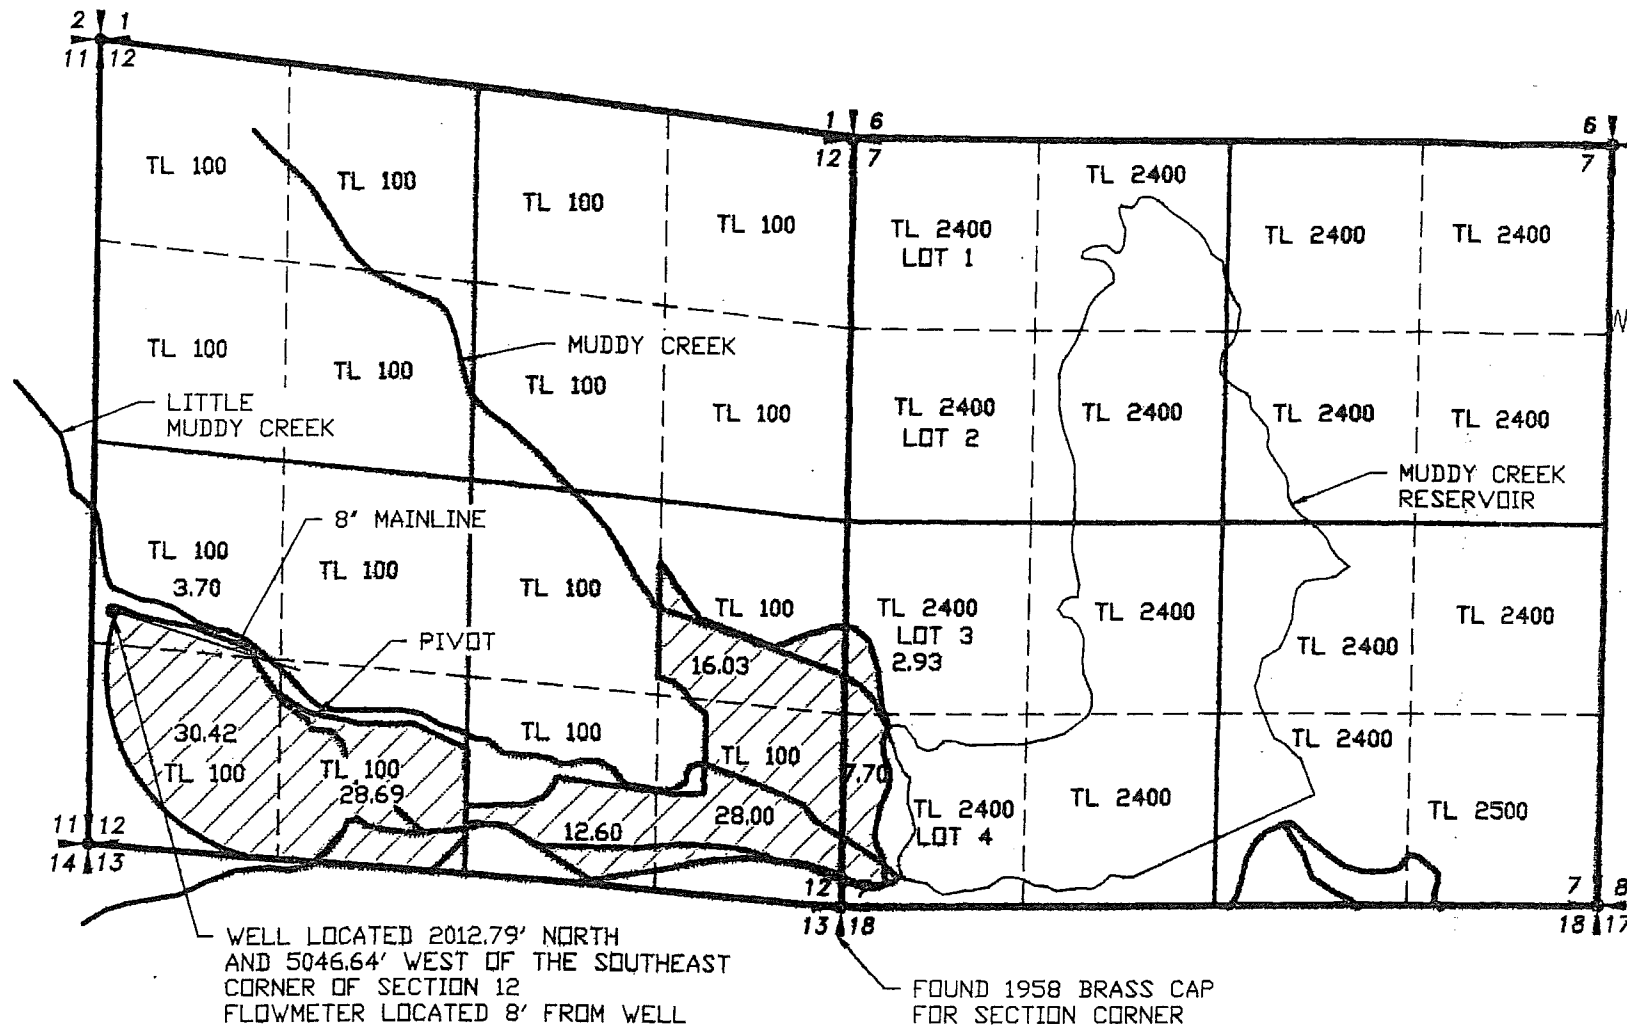

RECEIVED

JAN 06 2012

WATER RESOURCES DEPT
SALEM, OREGON

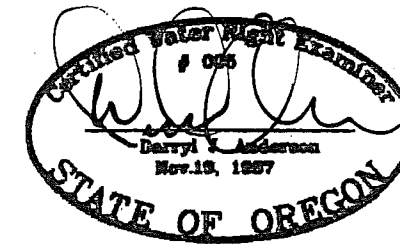

RENEWAL 12/31/13

LEGEND

- SECTION LINE
- 1/4 SECTION LINE
- 1/16 SECTION LINE
- - - IRRIGATION MAIN LINE
- DISTRIBUTION DITCH
- ▨ SUPPLEMENTAL IRRIGATION

SCALE: 1"=1320'

APPLICATION NO. G-9051

PERMIT NO. G-8409

COBU MAP #0644

NOTE:
PREPARATION OF THIS MAP IS FOR IDENTIFYING PROPOSED
WATER RIGHTS ONLY. IT HAS NO INTENT TO PROVIDE
LOCATIONS OR DIMENSIONS OF PROPERTY BOUNDARIES.

REVISION	BY

**ANDERSON ENGINEERING
AND SURVEYING, INC.**
P.O. BOX 28
LAKEVIEW, OREGON 97630
(541) 947-4407
FAX: 947-2321

FOR: **CHARLES K. KELLEY**
P.O. BOX 711
LAKEVIEW, OR 97630
541-947-3000

CLAIM OF BENEFICIAL USE MAP
APPLICATION NO. G-9051
PERMIT NO. G-8409

DATE:	11/02/11
SCALE:	1"=1320'
DRN. BY:	R.C.
JOB:	2011-001
FILE:	08409
SHEET:	1 OF 1

CLAIM OF BENEFICIAL USE MAP


FOR

CHARLES K. KELLEY

SECTION 12, TOWNSHIP 39 SOUTH RANGE 18 EAST

SECTION 7, TOWNSHIP 39 SOUTH RANGE 19 EAST


LAKE COUNTY, OREGON

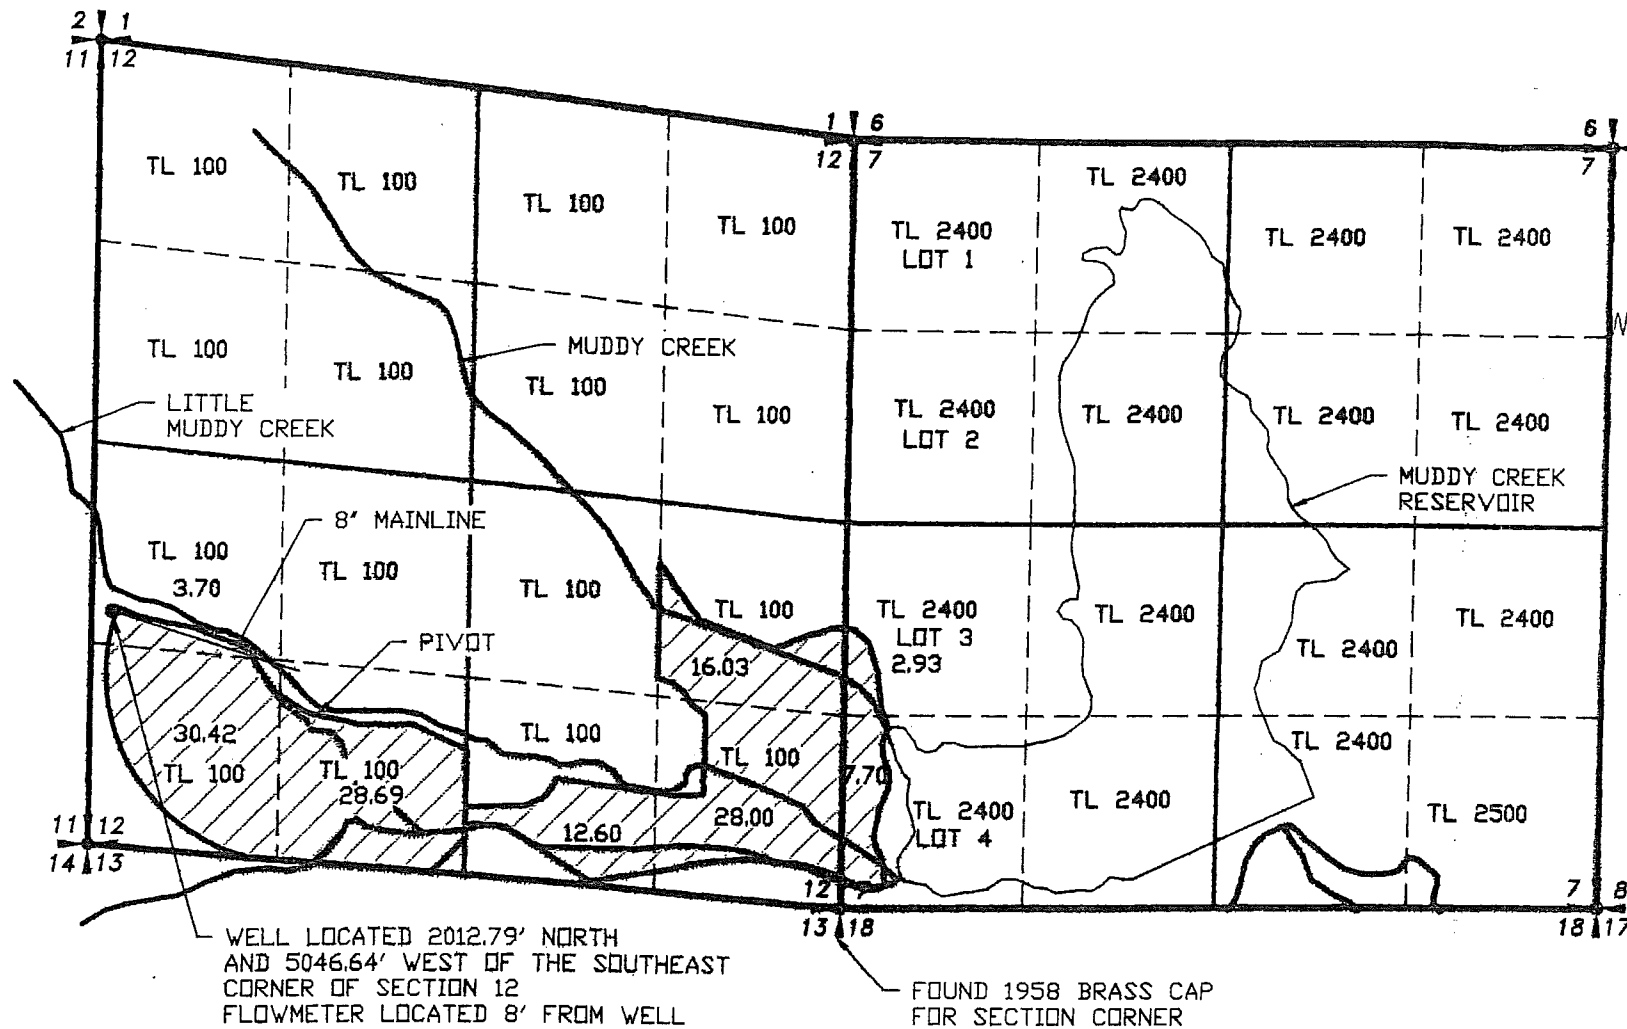

RECEIVED

JAN 06 2012

WATER RESOURCES DEPT
SALEM, OREGON

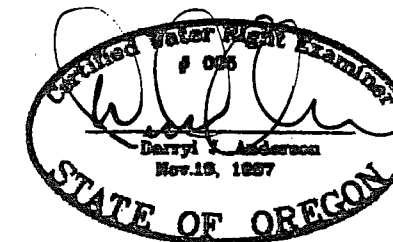

RENEWAL 12/31/13

LEGEND

- SECTION LINE
- 1/4 SECTION LINE
- 1/16 SECTION LINE
- IRRIGATION MAIN LINE
- DISTRIBUTION DITCH
- SUPPLEMENTAL IRRIGATION

SCALE: 1"=1320'

APPLICATION NO. G-9051

PERMIT NO. G-8409

COBU MAP #0644

NOTE:
PREPARATION OF THIS MAP IS FOR IDENTIFYING PROPOSED
WATER RIGHTS ONLY. IT HAS NO INTENT TO PROVIDE
LOCATIONS OR DIMENSIONS OF PROPERTY BOUNDARIES.

REVISION	BY

ANDERSON ENGINEERING
AND SURVEYING, INC.
P.O. BOX 28
LAKEVIEW, OREGON 97630
(541) 947-4407
FAX: 947-2321

FOR: CHARLES K. KELLEY
P.O. BOX 711
LAKEVIEW, OR 97630
541-947-3000

CLAIM OF BENEFICIAL USE MAP
APPLICATION NO. G-9051
PERMIT NO. G-8409

DATE:	11/02/11
SCALE:	1"=1320'
DRAWN BY:	R.C.
JOB:	2011-001
FILE:	08409
SHEET:	1 OF 1