

RECEIVED



JUL 28 1997

WATER RESOURCES DEPT.
SALEM, OREGON

FINAL PROOF SURVEY

APPLICATION NO. G-12652 PERMIT NO. G-11790
APPLICATION NO. G-13242 PERMIT NO. G-12542

IN THE NAME OF
JAN VAN DEN BERG

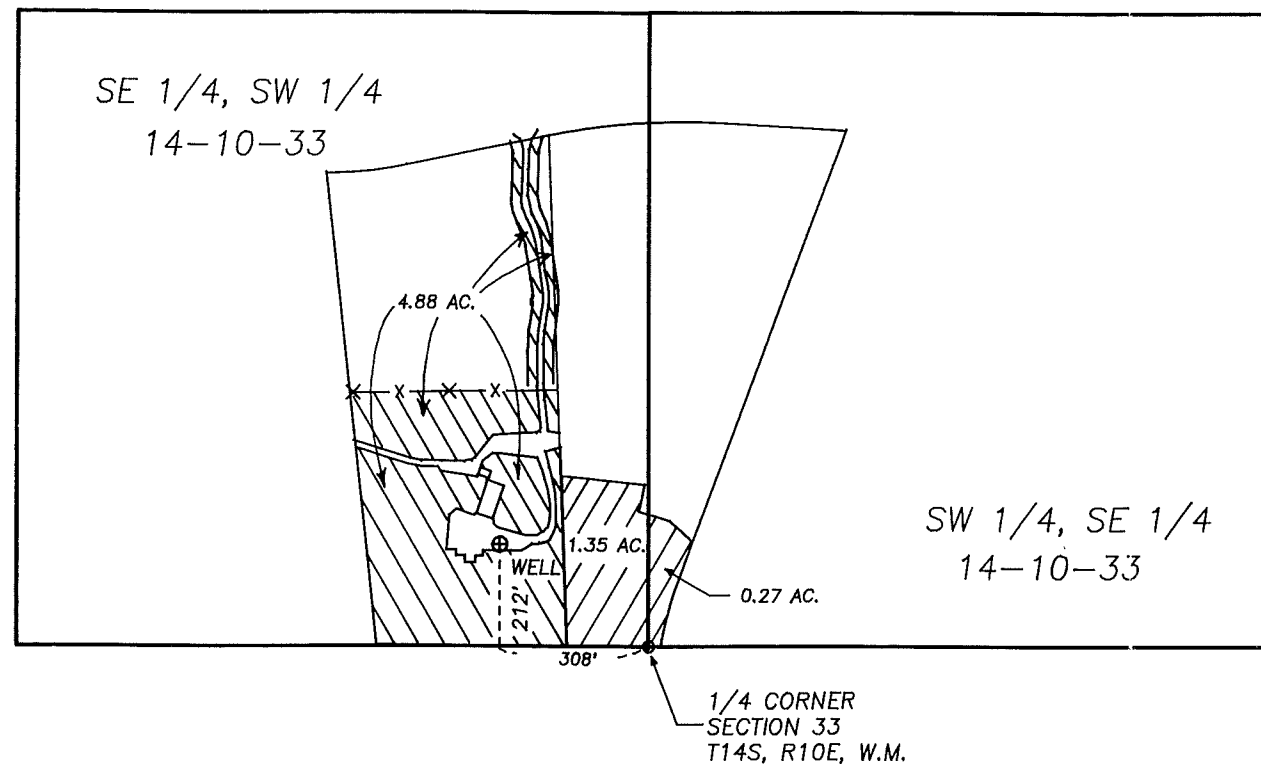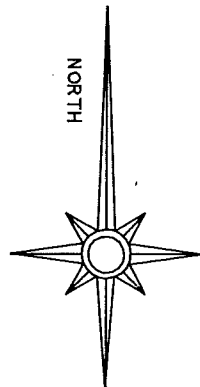


PARCEL DESCRIPTION


LOTS 1 AND 2, BLOCK 7, INDIAN FORD MEADOWS, SITUATED IN THE SOUTHEAST QUARTER AND THE SOUTHWEST QUARTER OF SECTION 33, T14S, R10E, W.M., DESCHUTES COUNTY, OREGON.




PERMIT G-11790

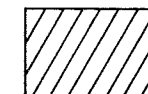

PERMIT G-12542

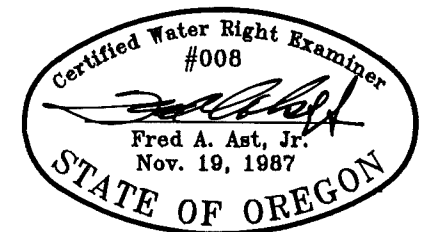

NOTE:
THIS MAP IS FOR THE PURPOSE OF IDENTIFYING THE LOCATION OF WATER RIGHT. IT IS NOT INTENDED TO PROVIDE INFORMATION RELATIVE TO THE LOCATION OF PROPERTY BOUNDARY LINES.

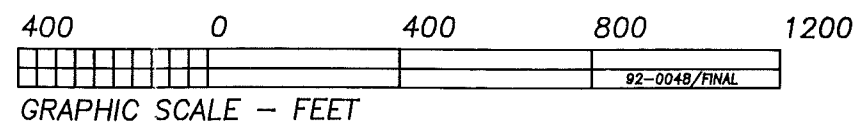

FRED A. AST, Jr & ASSOCIATES

Land Surveying & Water Rights
250 W. Cascade St. - P.O. Box 751
Sisters, Oregon ***** 97759
Phone: (541) 549 - 7851