


SECTION 6, T18S, R43E, W.M.

DISCLAIMER

THIS MAP IS FOR THE PURPOSE OF IDENTIFYING THE LOCATION OF THE WATER RIGHT ONLY AND HAS NO INTENT TO PROVIDE DIMENSIONS OR LOCATION OF PROPERTY OWNERSHIP LINES

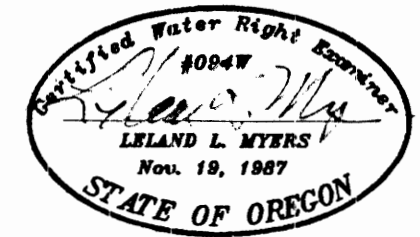


APPLICATION No.: G-13188

PERMIT No.: G-12019

IN THE NAME OF
FOSTER BROTHERS
P.O. BOX 456
VALE, OR 97918

SEC. 6

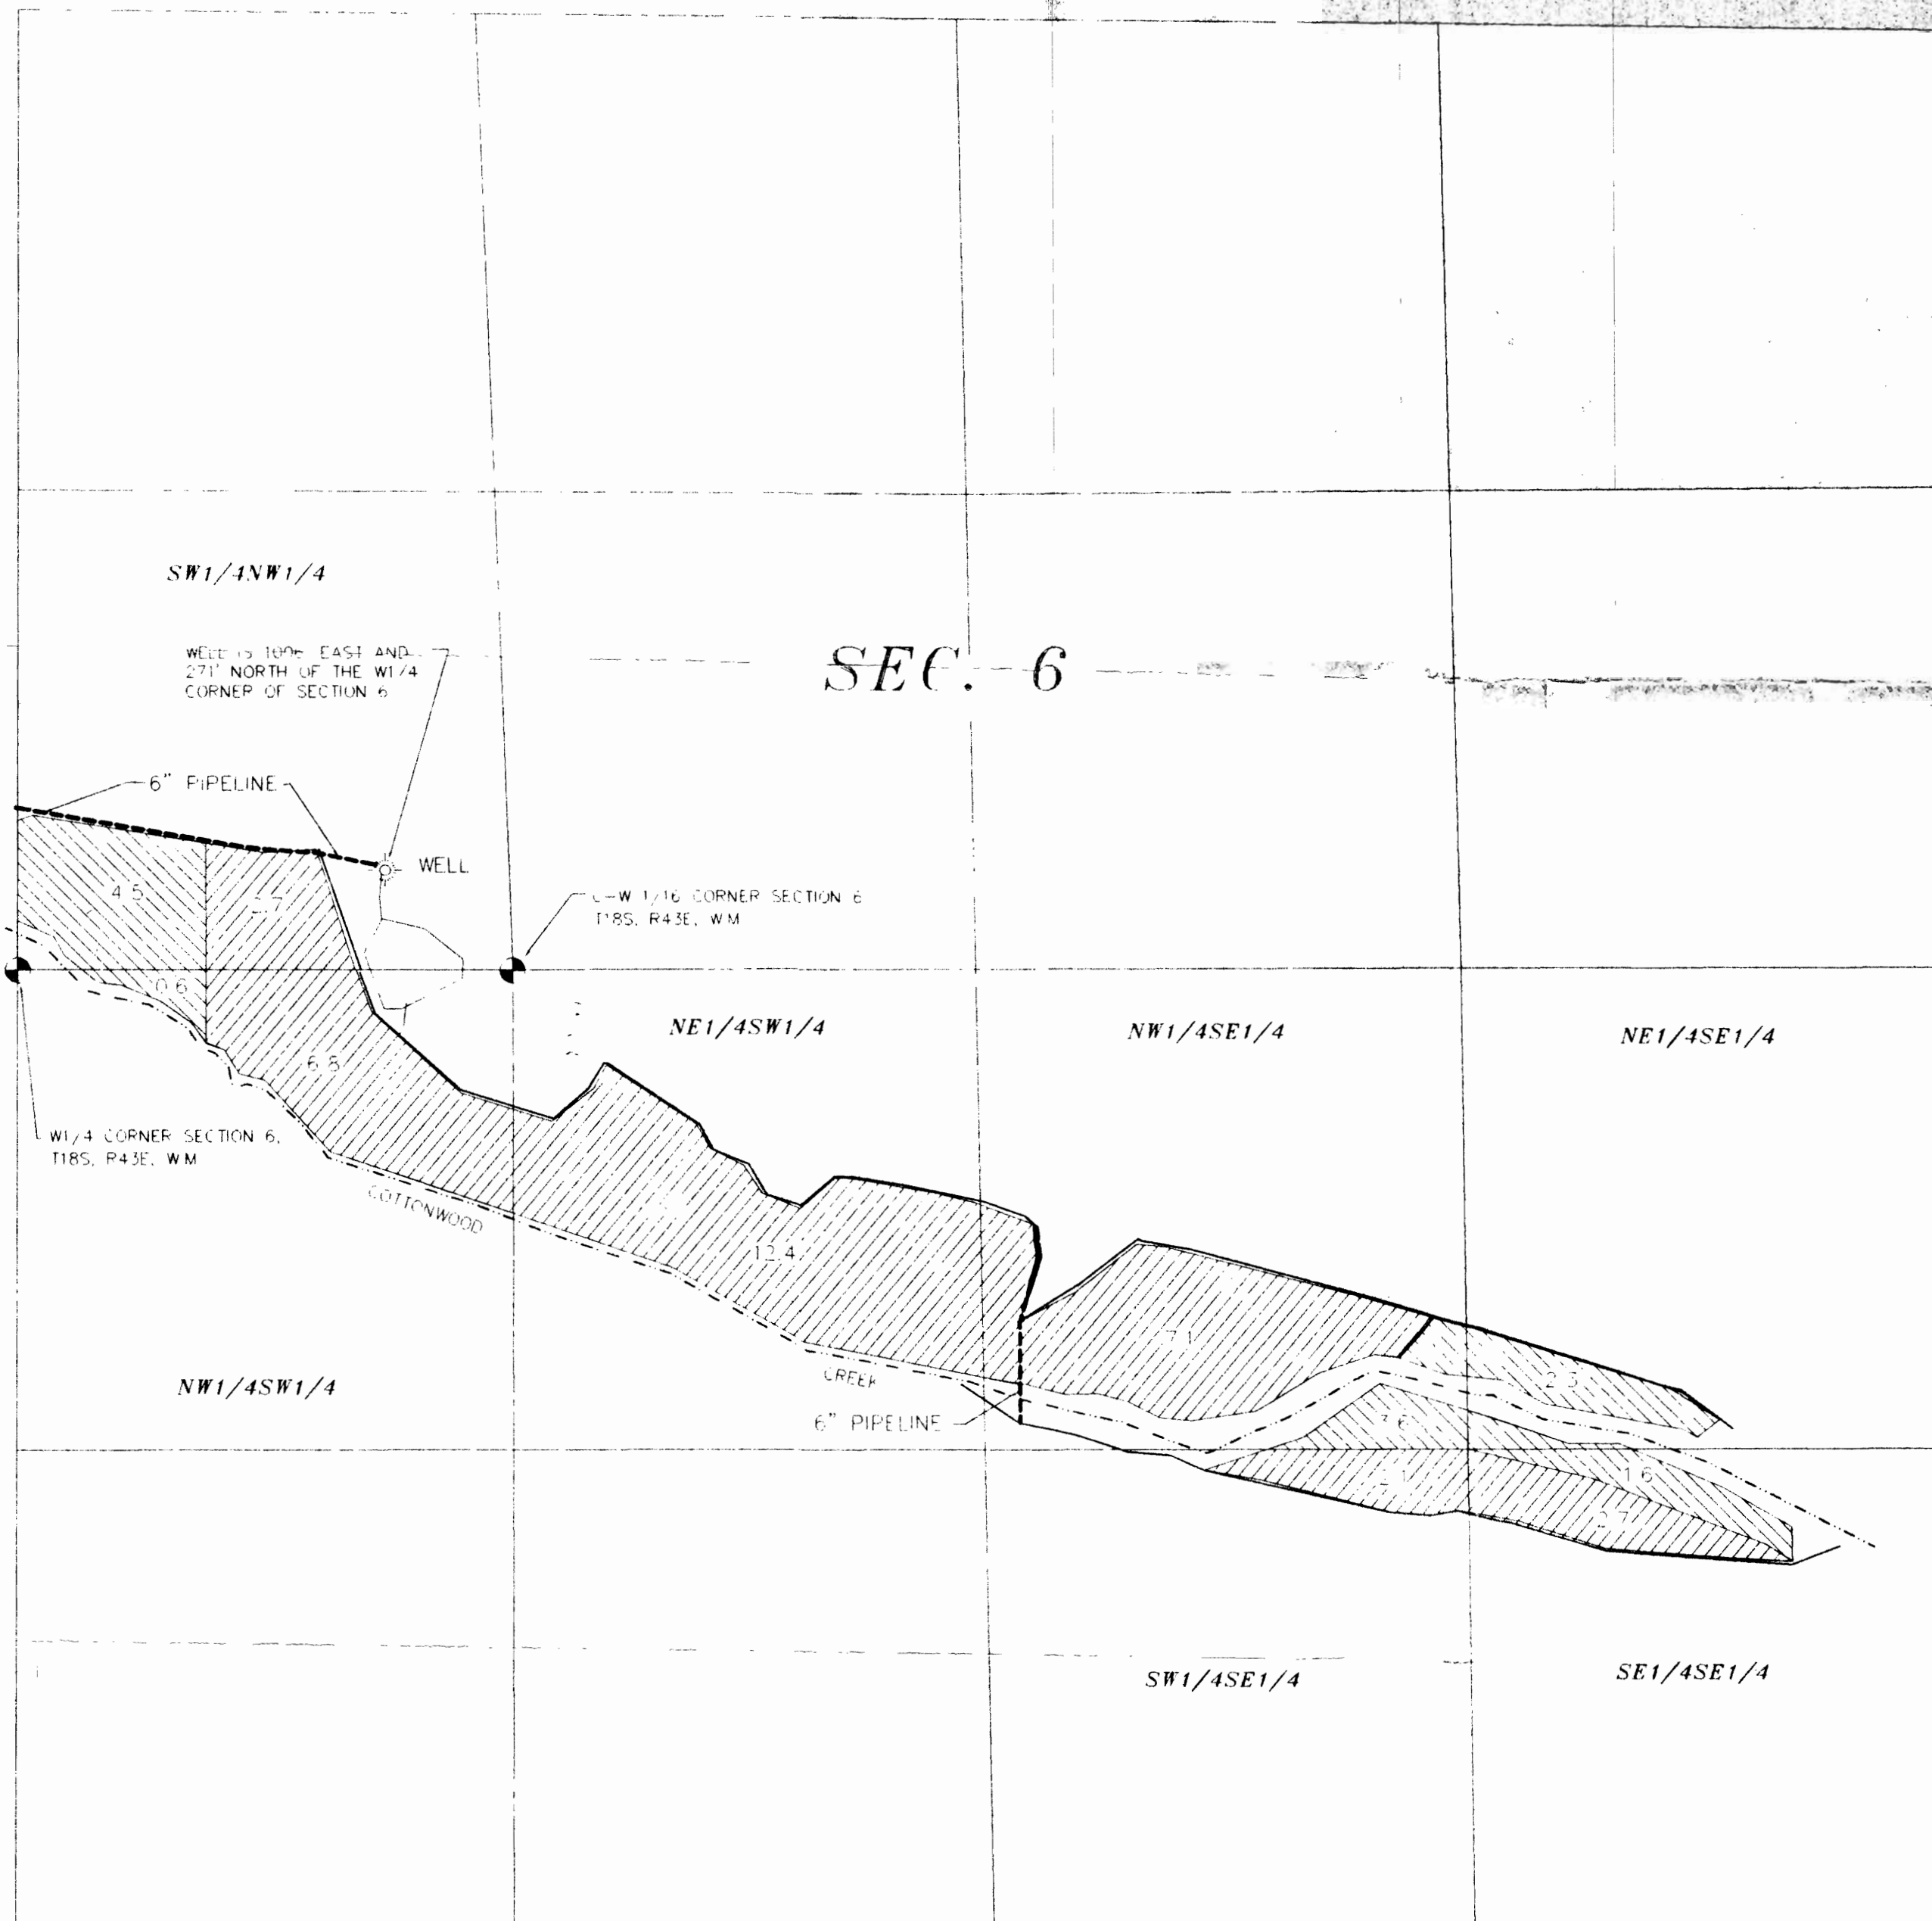

LEGEND

GOVERNMENT CORNER	
2'X1' EARTH DITCH	
CREEK	
PIPELINE	
WELL	
PRIMARY	
SUPPLEMENTAL	

SCALE 1" = 400'

FINAL PROOF SURVEY		
FOR : FOSTER BROTHERS		
GASCHLER & CUMMINGS		
CIVIL ENGINEERING & LAND SURVEYING		
156 SE 1st. AVE. 889-2101 ONTARIO, OREGON		
CHECKED BY: LLM	DRAWN BY: ECH	APPROVED BY: LLM