

FINAL PROOF SURVEY

**NEW WELL LOCATION
(WELL NO. 7)**

27

26

25

30

**CITY OF
Dundee**

61


61

31

**SERVICE
BOUNDARY**

36

35

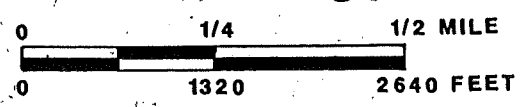

SCALE
Certified Water Right Examiner
163
Jon E. Erwin
Jon E. Erwin
May 17, 1988
STATE OF OREGON

T. 3 S.

R. 2 W.

