

SECTIONS 25 & 36, TWP.2 N. RANGE 20 E. AND  
 SECTIONS 19, 30 & 31, TWP.2 N. RANGE 21 E. W.M.

GILLIAM COUNTY, OREGON


RECEIVED

OCT - 3 1994

WATER RESOURCES DEPT.  
 SALEM, OREGON

FINAL PROOF SURVEY

SCALE: 1" = 1320'

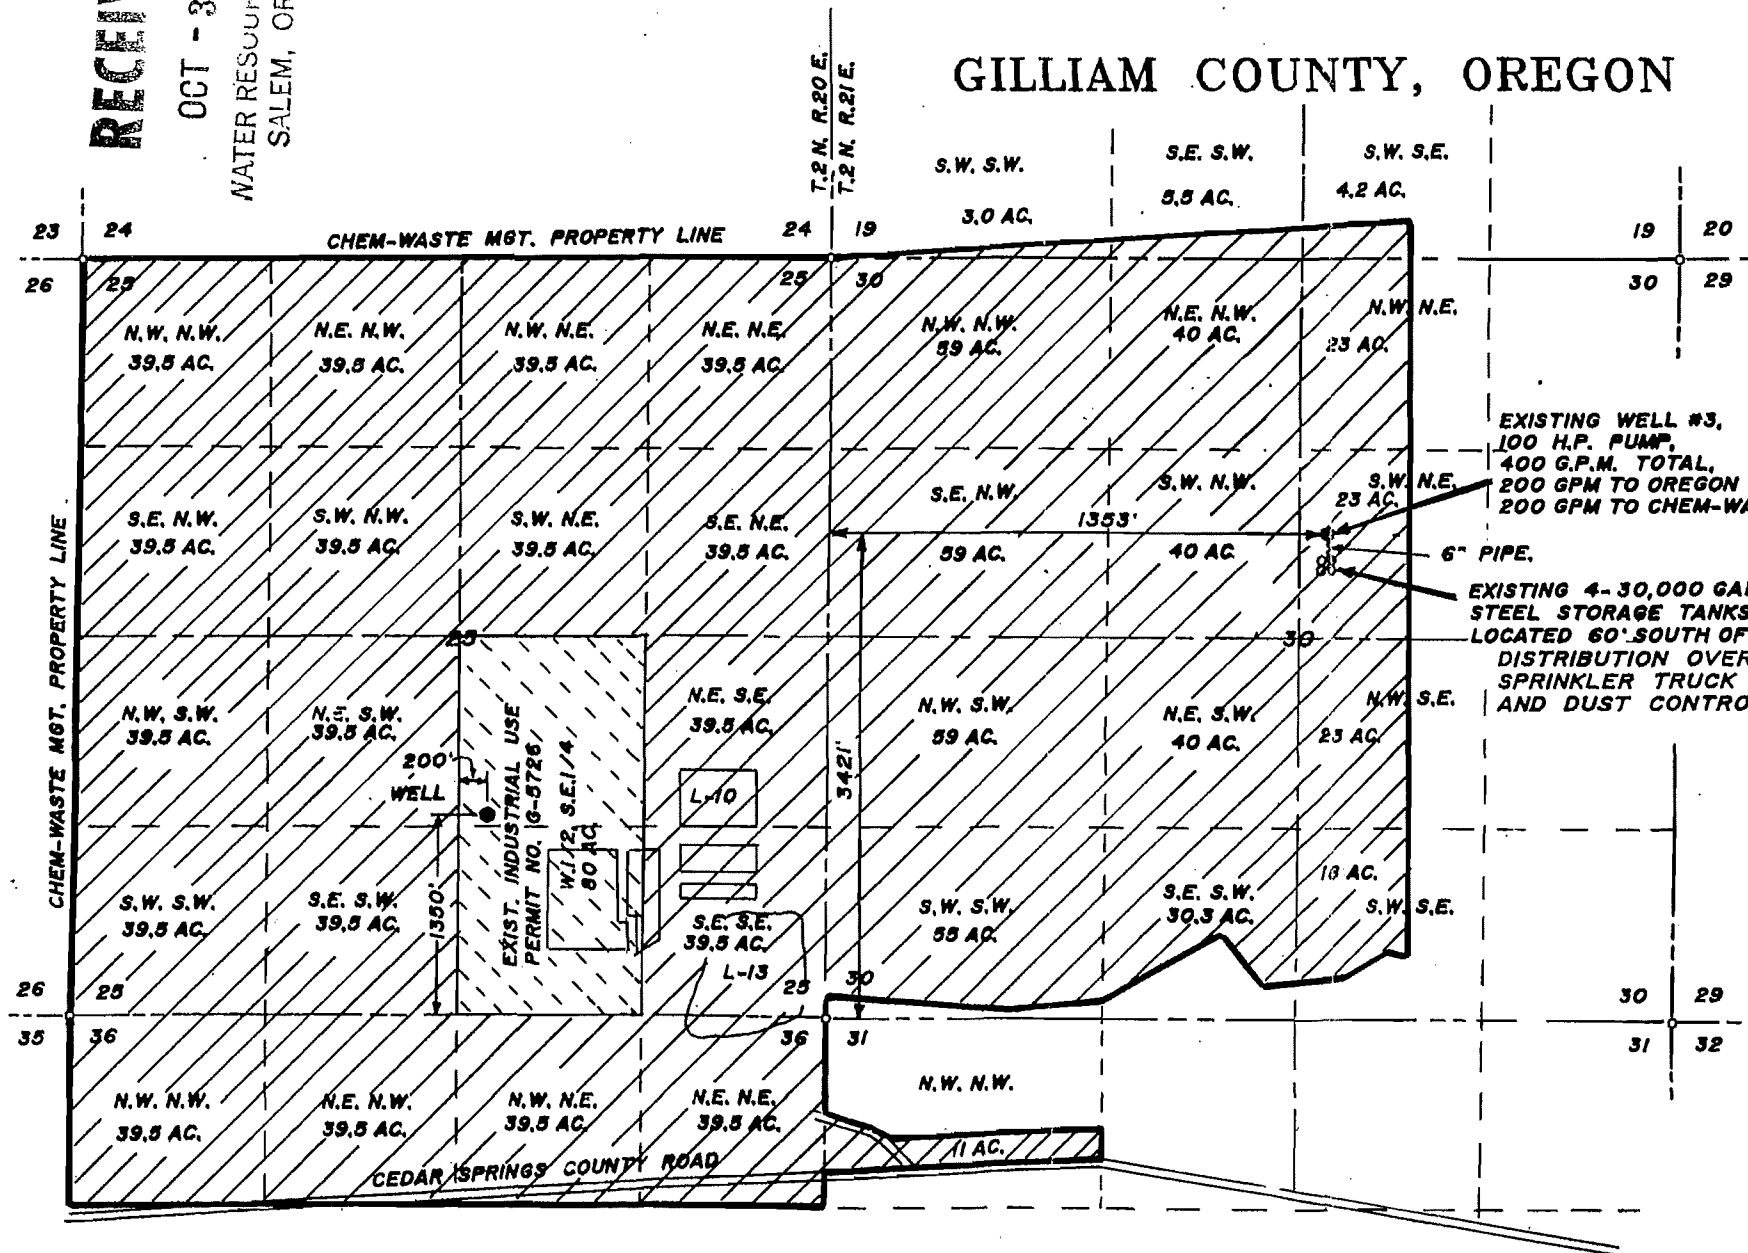


PERMIT No. T-6740 (G-8547)  
G-11667  
 IN THE NAME OF:  
CHEM-WASTE MGT. OF THE NORTHWEST  
 DATE: SEPTEMBER 20, 1994



BY: TENNESON ENGINEERING CORP.  
 409 LINCOLN STREET,  
 THE DALLES, OREGON. 97058  
 PH. (503) 296-9177

RECEIVED

SEP 29 2008

WATER RESOURCES DEPT  
 SALEM, OREGON

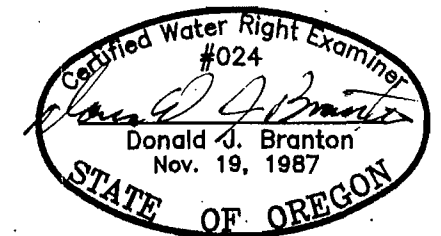

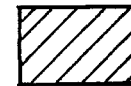-  INDUSTRIAL USE AREA, 1204 ACRES TOTAL,  
 0.4464 C.F.S. NOW COVERED DURING IRRIGATION SEASON ONLY  
 UNDER PERMITS G-8547 & T-6740 WITH THESE RIGHTS  
 SUPPLEMENTAL TO P-11667 COVERAGE.
-  EXISTING INDUSTRIAL USE AREA, PERMIT G-5726, (UNCHANGED)


**NOTE:**  
 "THIS MAP IDENTIFIES THE LOCATION OF  
 THE WATER RIGHT ONLY AND IS NOT  
 INTENDED TO PROVIDE DIMENSIONS OR  
 LOCATE PROPERTY OWNERSHIP LINES."

GILLIAM COUNTY, OREGON

RECEIVED

OCT - 3 1994

WATER RESOURCES DEPT.  
SALEM, OREGON

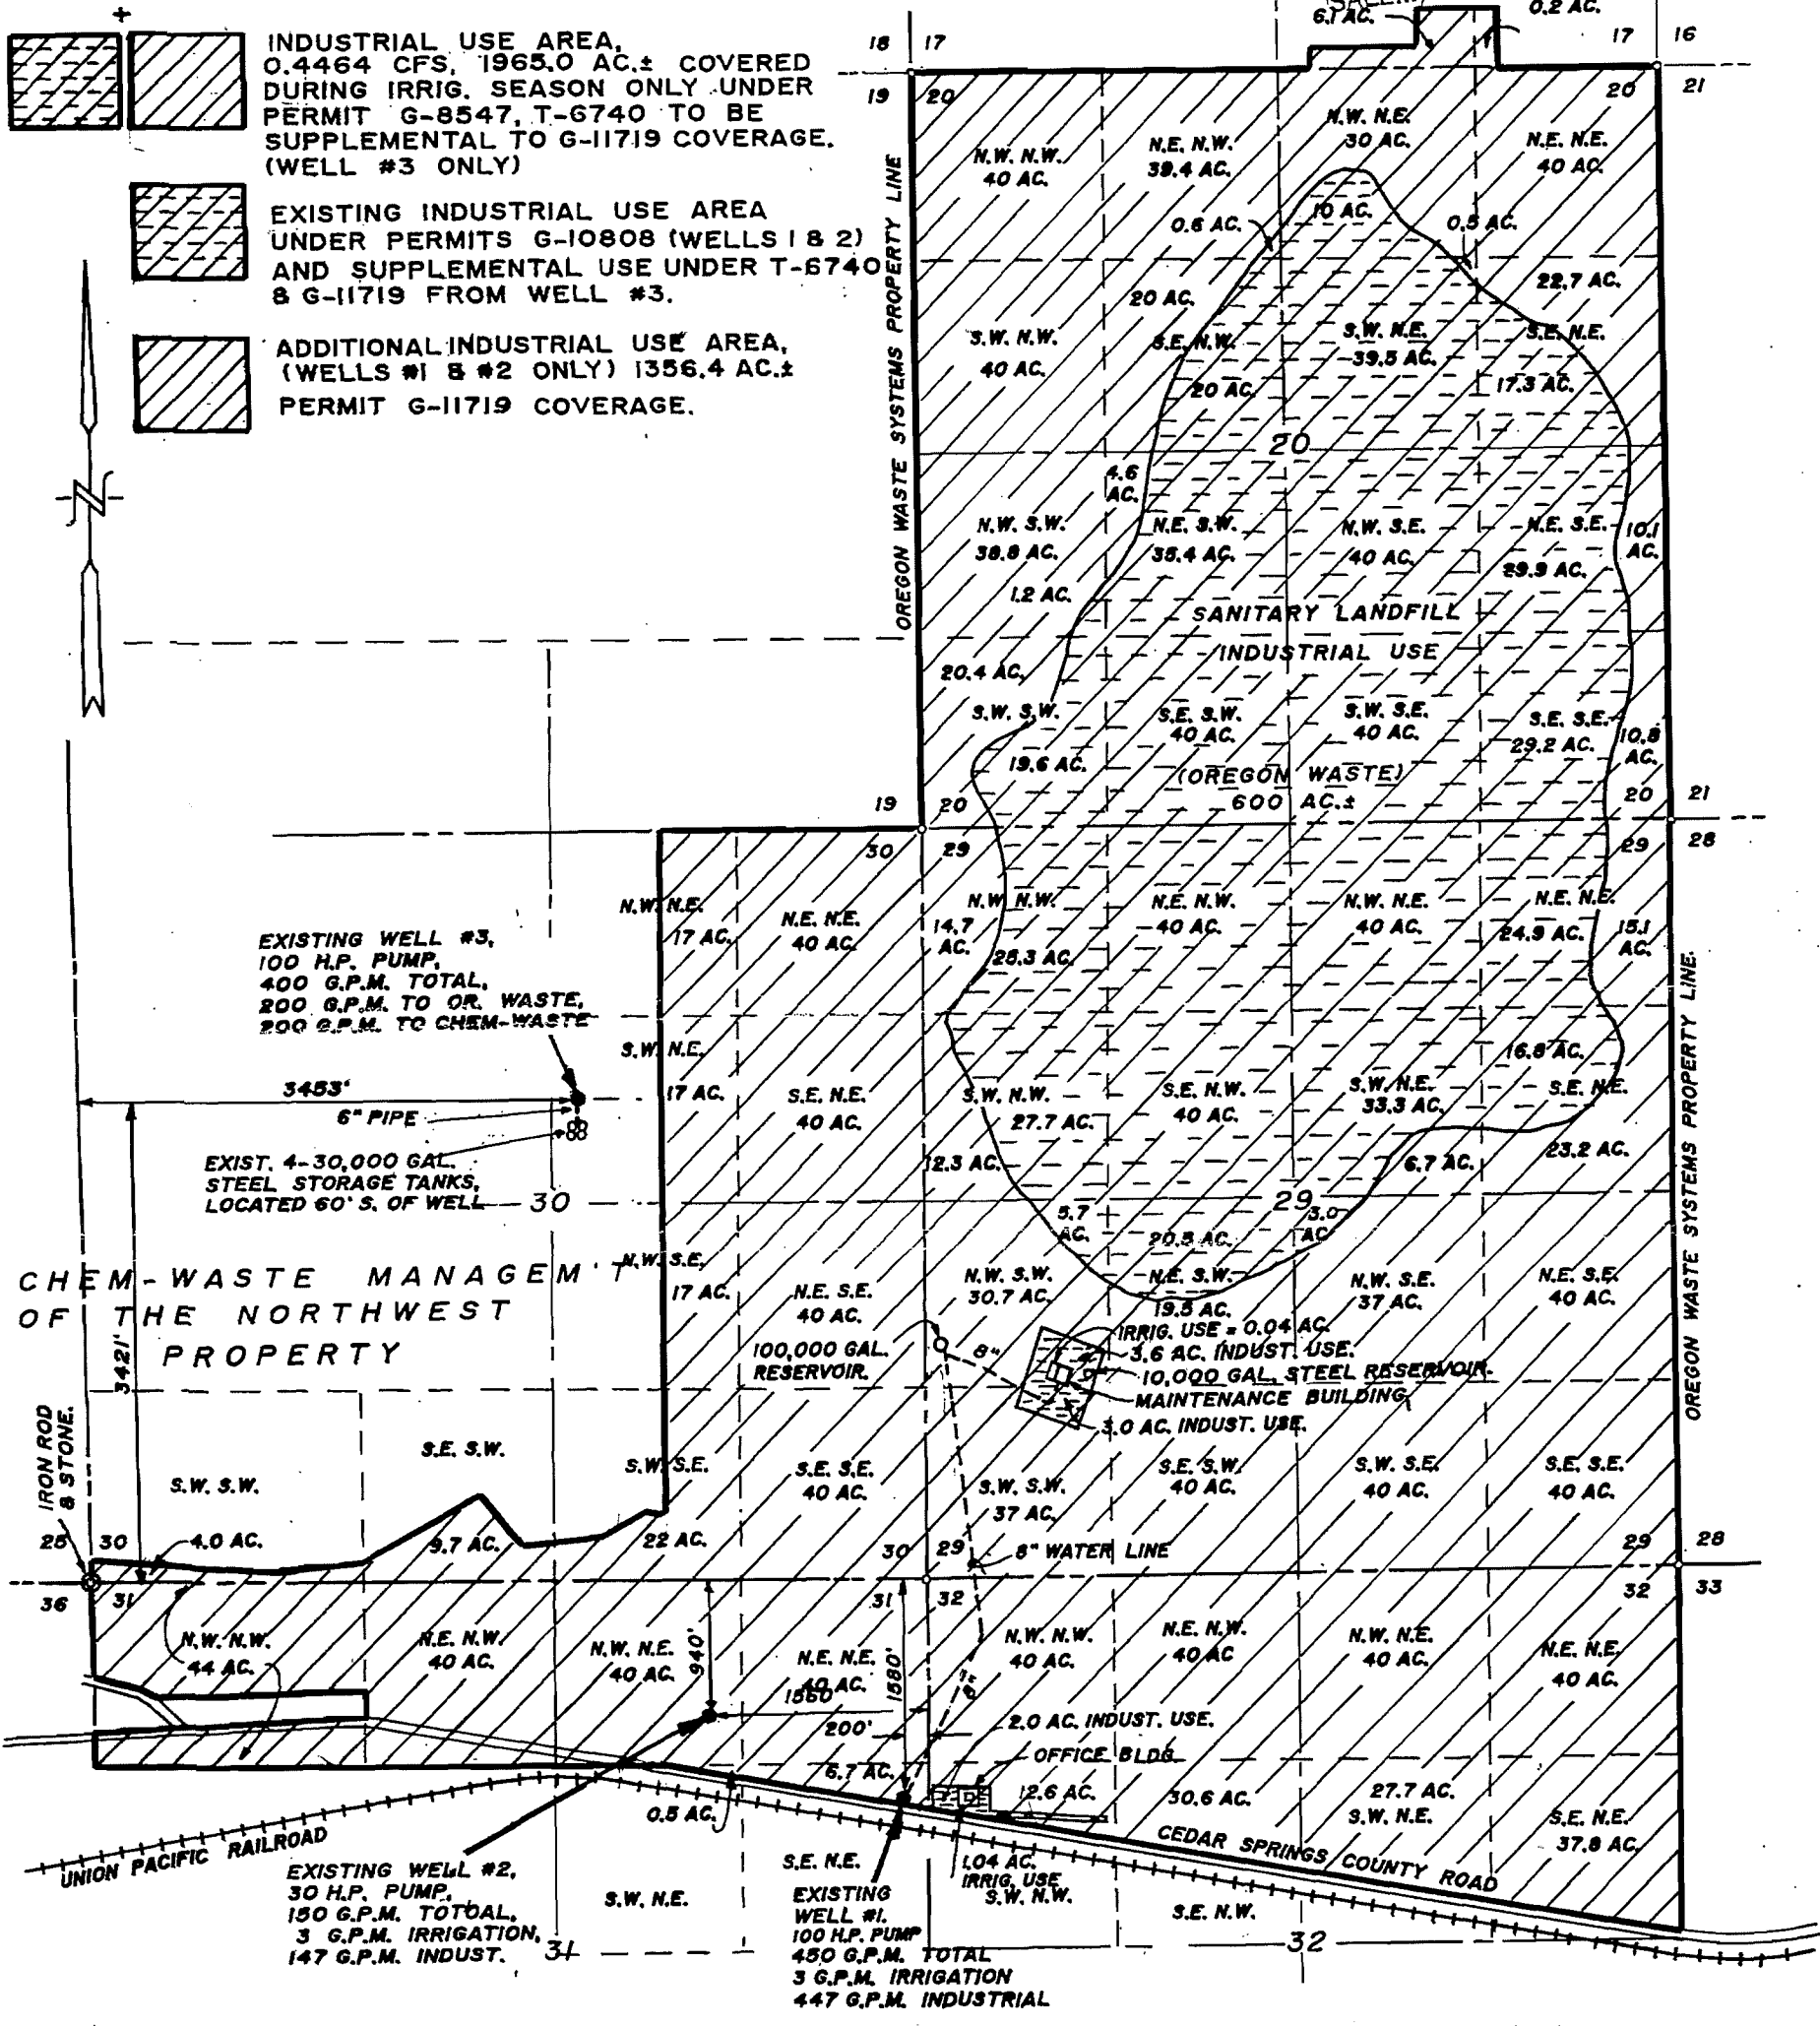

**FINAL PROOF SURVEY**

SCALE: 1" = 1320'

PERMIT No. T-6740 (G-8547)  
G-11719

IN THE NAME OF:  
OREGON WASTE SYSTEMS, INC.  
(COLUMBIA RIDGE LANDFILL & RECYCLING CENTER)


DATE: SEPTEMBER 20, 1994

BY: TENNESON ENGINEERING CORP.  
409 LINCOLN STREET,  
THE DALLES, OREGON. 97058  
PH. (503) 296-9177

WATER RESOURCES DEPT.  
SALEM, OREGON

SEP 29 2008

RECEIVED

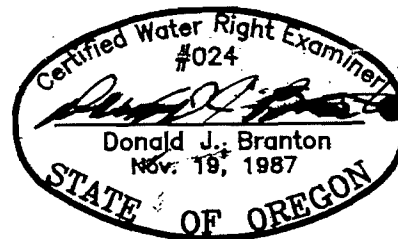

**NOTE:**


"THIS MAP IDENTIFIES THE LOCATION OF THE WATER RIGHT ONLY AND IS NOT INTENDED TO PROVIDE DIMENSIONS OR LOCATE PROPERTY OWNERSHIP LINES."

W.O. #7750

# Claim of Beneficial Use - Point of Appropriation Map

## Waste Management & Disposal Services of Oregon, Inc.

### Transfer T-10065

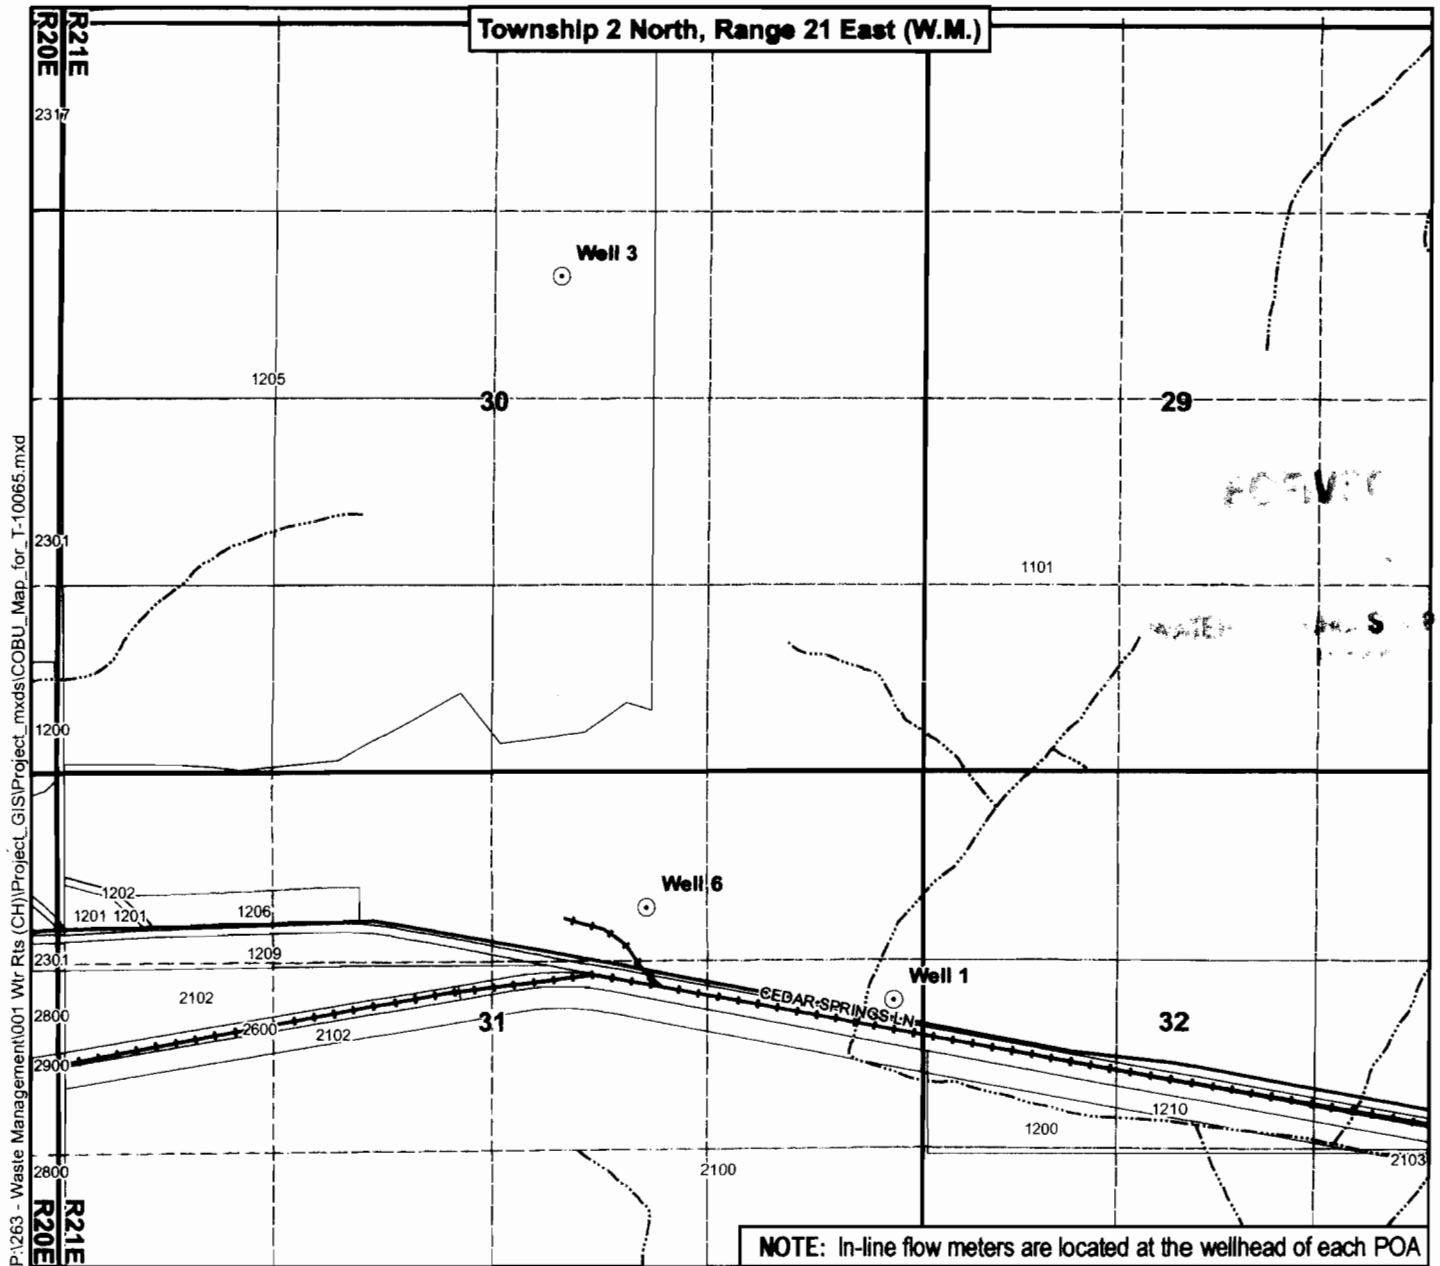

P:\1263 - Waste Management\001 Wtr Rts (CH)\Project\_GIS\Project\_mxd\COBU\_Map\_for\_T-10065.mxd

#### Legend


- Point of Appropriation (POA)
- ⊕ Tax Lots
- Roads
- Railroads
- ~ Watercourses

#### Map Information

Projection: Oregon State Plane North Zone  
 Datum: North American Datum of 1983  
 Date: June 5, 2008  
 Prepared By: GSI Water Solutions, Inc.

#### POA Location Descriptions

- Well 1**  
 Located 1,580 feet South and 200 feet West from the NE corner of Section 31, Township 2 North, Range 21 East (W.M.)
- Well 3**  
 Located 3,421 feet North and 3,453 feet East from the SW corner of Section 30, Township 2 North, Range 21 East (W.M.)
- Well 6**  
 Located 940 feet South and 1,910 feet West from the NE corner of Section 31, Township 2 North, Range 21 East (W.M.)

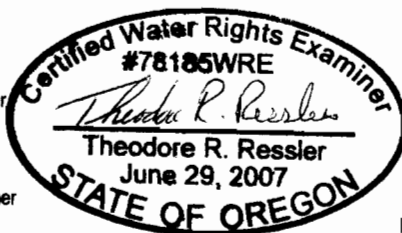

**EXPIRES: 12-31-2008**

**Data Sources**  
 OWRD, Gilliam County, Oregon Geospatial Data Clearinghouse

**Disclaimer**  
 This map was prepared for the purpose of identifying the location of a water right only and it is not intended to provide legal dimensions or location of property ownership lines.



**Scale**  
 0 330 660 1,320  
 1 inch equals 1,320 feet

