


- IRRIGATION AREA
PER TRANSFER T-7055
- POINT OF DIVERSION (POD)
- WATER MAIN PIPES
- PROPERTY BOUNDARY LINE
- TAX LOT LINE
- 1/16TH SECTION

COBU MAP # 0651

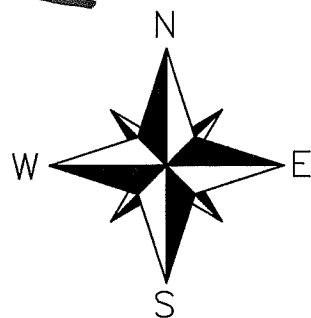

GRAPHIC SCALE
0 400 800
1 inch = 400 ft.

MAP BASES: WASHINGTON COUNTY TAX MAPS T2S R2W SEC. 20
2010 AERIAL PHOTO FROM GOOGLE EARTH AND
FINAL PROOF OF SURVEYS FOR CERTIFICATE 23410 & 28494

THIS MAP WAS PREPARED FOR THE PURPOSE OF IDENTIFYING THE LOCATION OF A
WATER RIGHT ONLY AND IS NOT INTENDED TO PROVIDE LEGAL DIMENSIONS OR
LOCATION OF PROPERTY OWNERSHIP LINES.

Y:\2011\3112057 Jaquith, Joseph\dwg\311-2-057-COBU.dwg Dec 12, 2011 - 11:36am


CLAIM OF BENEFICIAL USE MAP

SECTION 20, T2S, R2W, WM
LOT 400 OF TAX MAP 2S 2W SEC. 20
WASHINGTON COUNTY, OREGON
TRANSFER T-7055

PREPARED FOR:
JOSEPH JAQUITH
23030 SW JAQUITH ROAD
NEWBERG, OREGON 97132

RECEIVED

JAN 17 2012
WATER RESOURCES DEPT
SALEM, OREGON

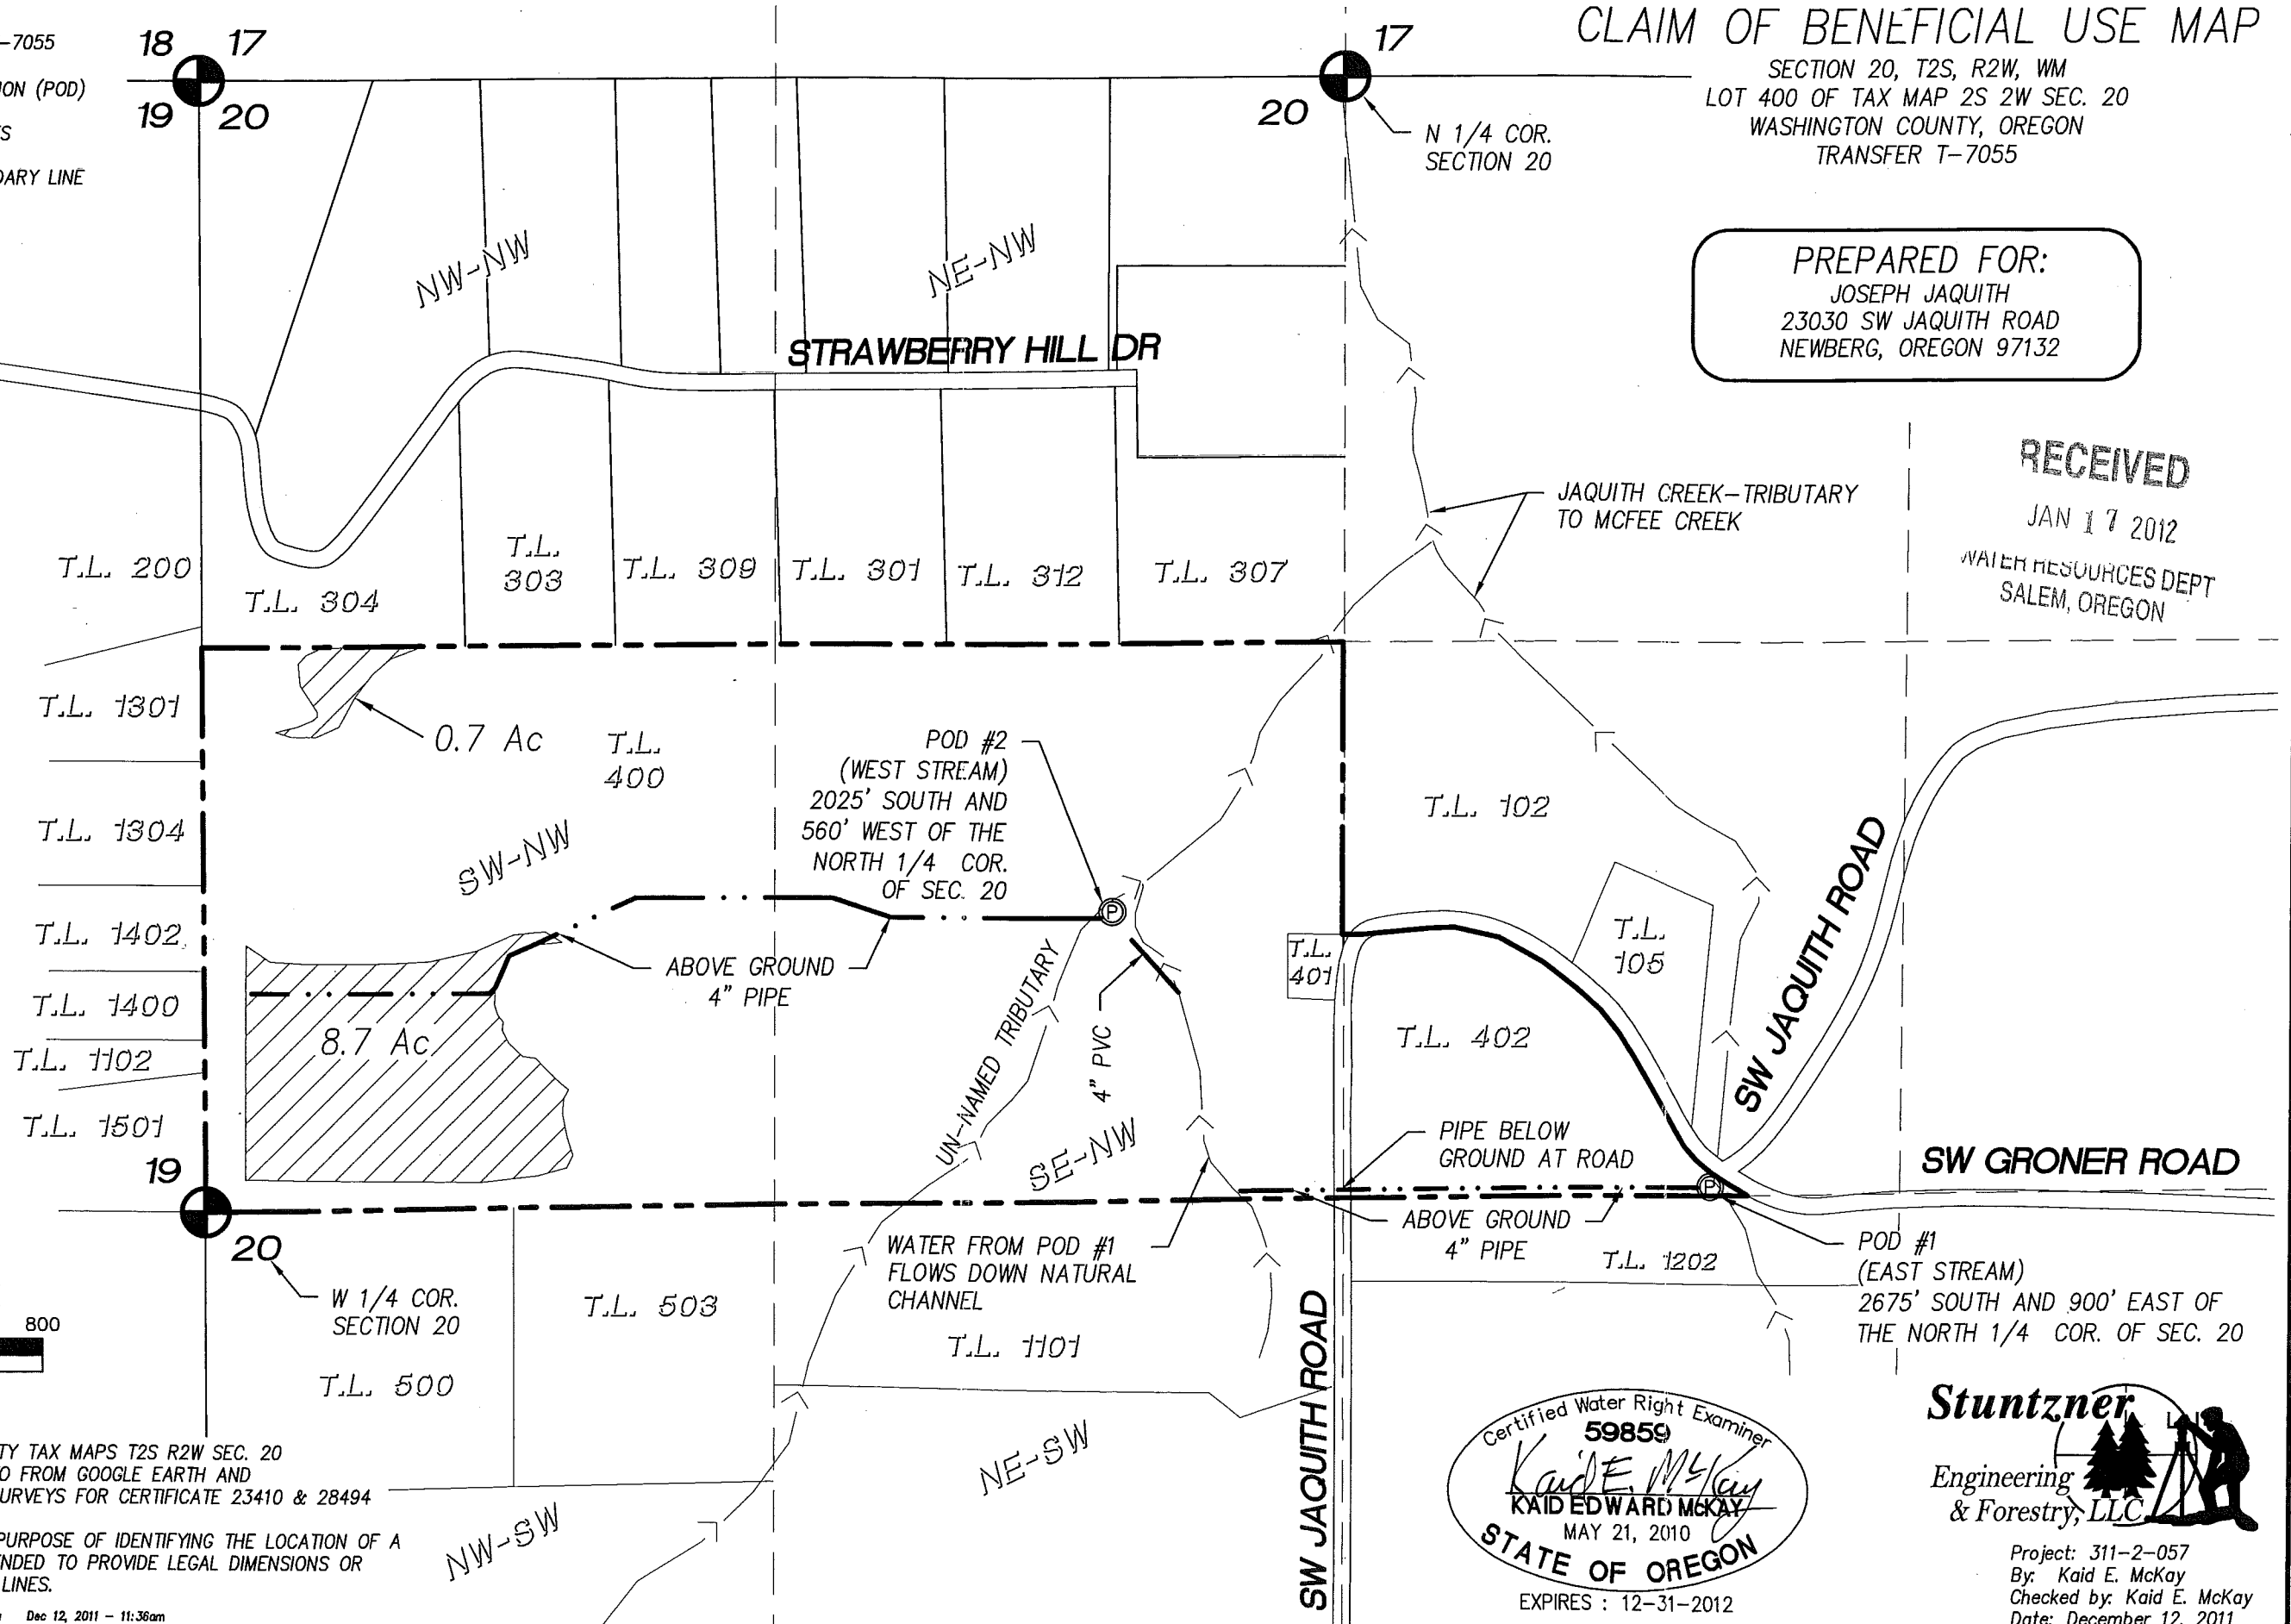

Certified Water Right Examiner
59859
Kaid E. McKay
KAID EDWARD MCKAY
MAY 21, 2010
STATE OF OREGON
EXPIRES : 12-31-2012

Stuntzner
Engineering
& Forestry, LLC

Project: 311-2-057
By: Kaid E. McKay
Checked by: Kaid E. McKay
Date: December 12, 2011

0651