

RECEIVED

FEB 24 2012

RESOURCES DE
SALEM, OREGON

CLAIM OF BENEFICIAL USE MAP

TRANSFER T-11010

IRRIGATION

FOR

CLIFTON AND DEBRA GEDDIS


17031 MONTEREY ROAD

LAKE ELSINORE, CALIFORNIA 92530

SITUATED IN


SECTION 11, TOWNSHIP 34 SOUTH, RANGE 1 EAST, W.M.

JACKSON COUNTY, OREGON

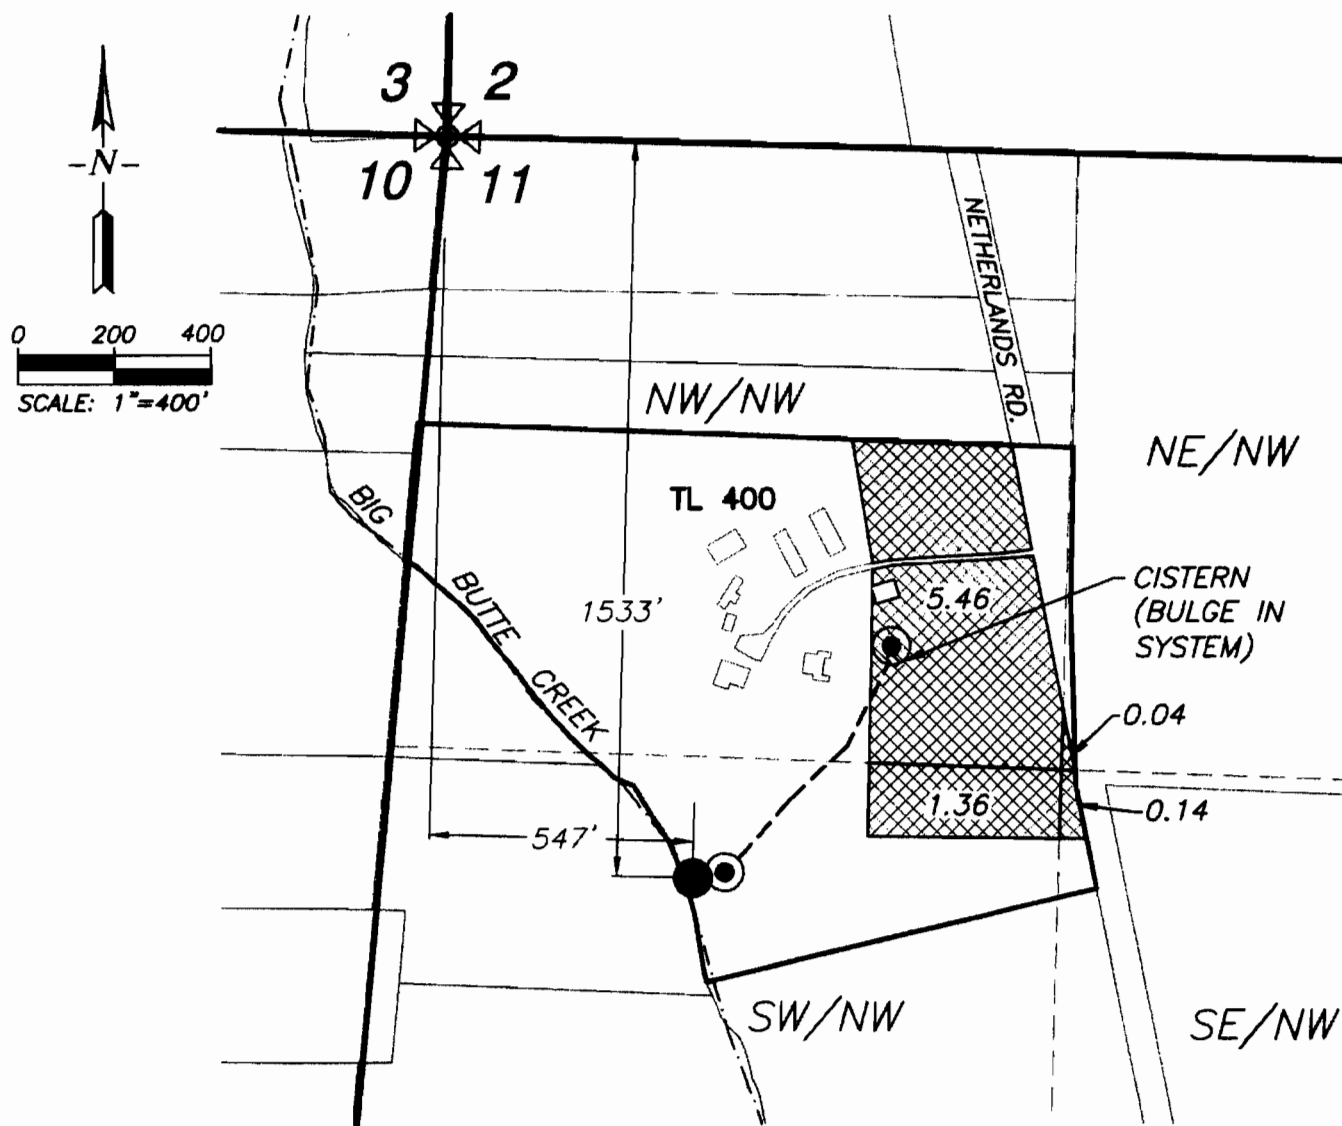

LEGEND

- POINT OF DIVERSION (POD 1) & FISH SCREEN
- ⊙ PUMP
- 1/4-1/4 SECTION LINE
- CISTERN FILL PIPE
- ▨ PLACE OF USE

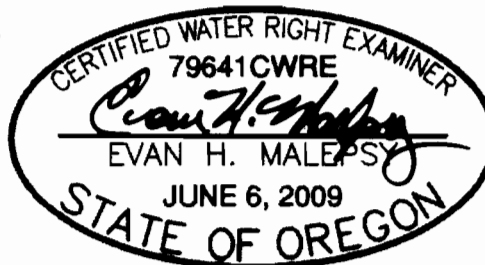

PXX Public Works Management, Inc.

This map is not intended to provide legal dimensions or locations of property ownership lines.

RENEWS: 12/31/2012

EHM-February 6, 2012