# T37S R3E W.M.
# SECTION 18

RECEIVED
SEP 27 1993
WATER RESOURCES DEPT
SALEM, OREGON

**THIS MAP IS NOT A SURVEY OF PROPERTY BOUNDARIES: FOR WATER RIGHTS LOCATION ONLY**

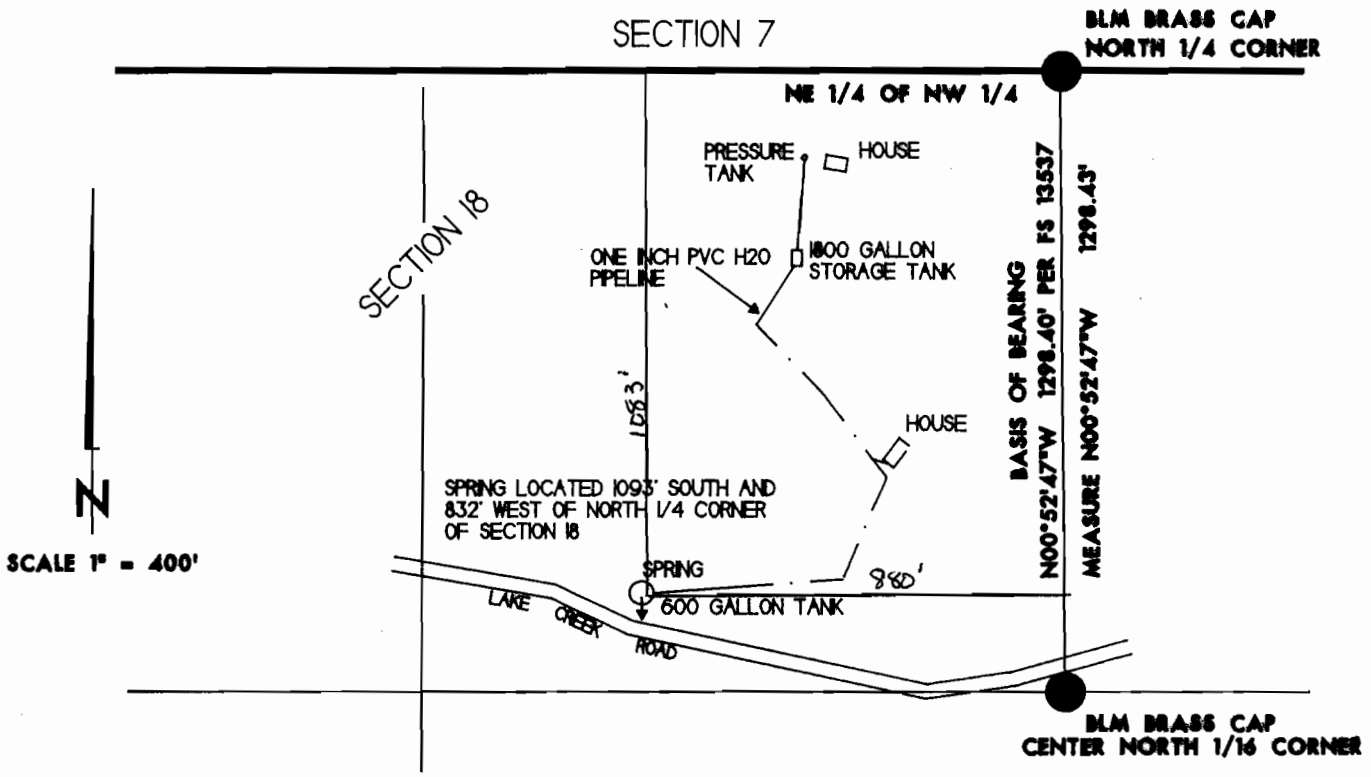


# FINAL PROOF SURVEY

**APPLICATION NO.** 69449 **PERMIT NO.** 50526

**IN THE NAME OF**

**ROSANNE M. B. LEADFORD**

Certified Water Right Examiner
233
Kerry K. Bradshaw
Kerry K. Bradshaw
May, 22, 1990
STATE OF OREGON

**SURVEYED BY KERRY K. BRADSHAW WRE 233**

**SEPTEMBER 15,1993**

Amended by WRD staff to reflect coordinates of spring. 5-2-08 jwg