


RECEIVED

OCT 28 2011

Claim of Beneficial Use Place of Use Map
Water Right in the Name of City of Toledo
 Permit S-9370, Application S-9834
 Township 11 South, Range 10 West (W.M.)

WATER RESOURCES DEPT
 SALEM, OREGON


File Path: P:\Portland\413-City of Toledo\001-Water Rights\Project GIS\Project mxd\Permit S9370 COBU POU Map.mxd

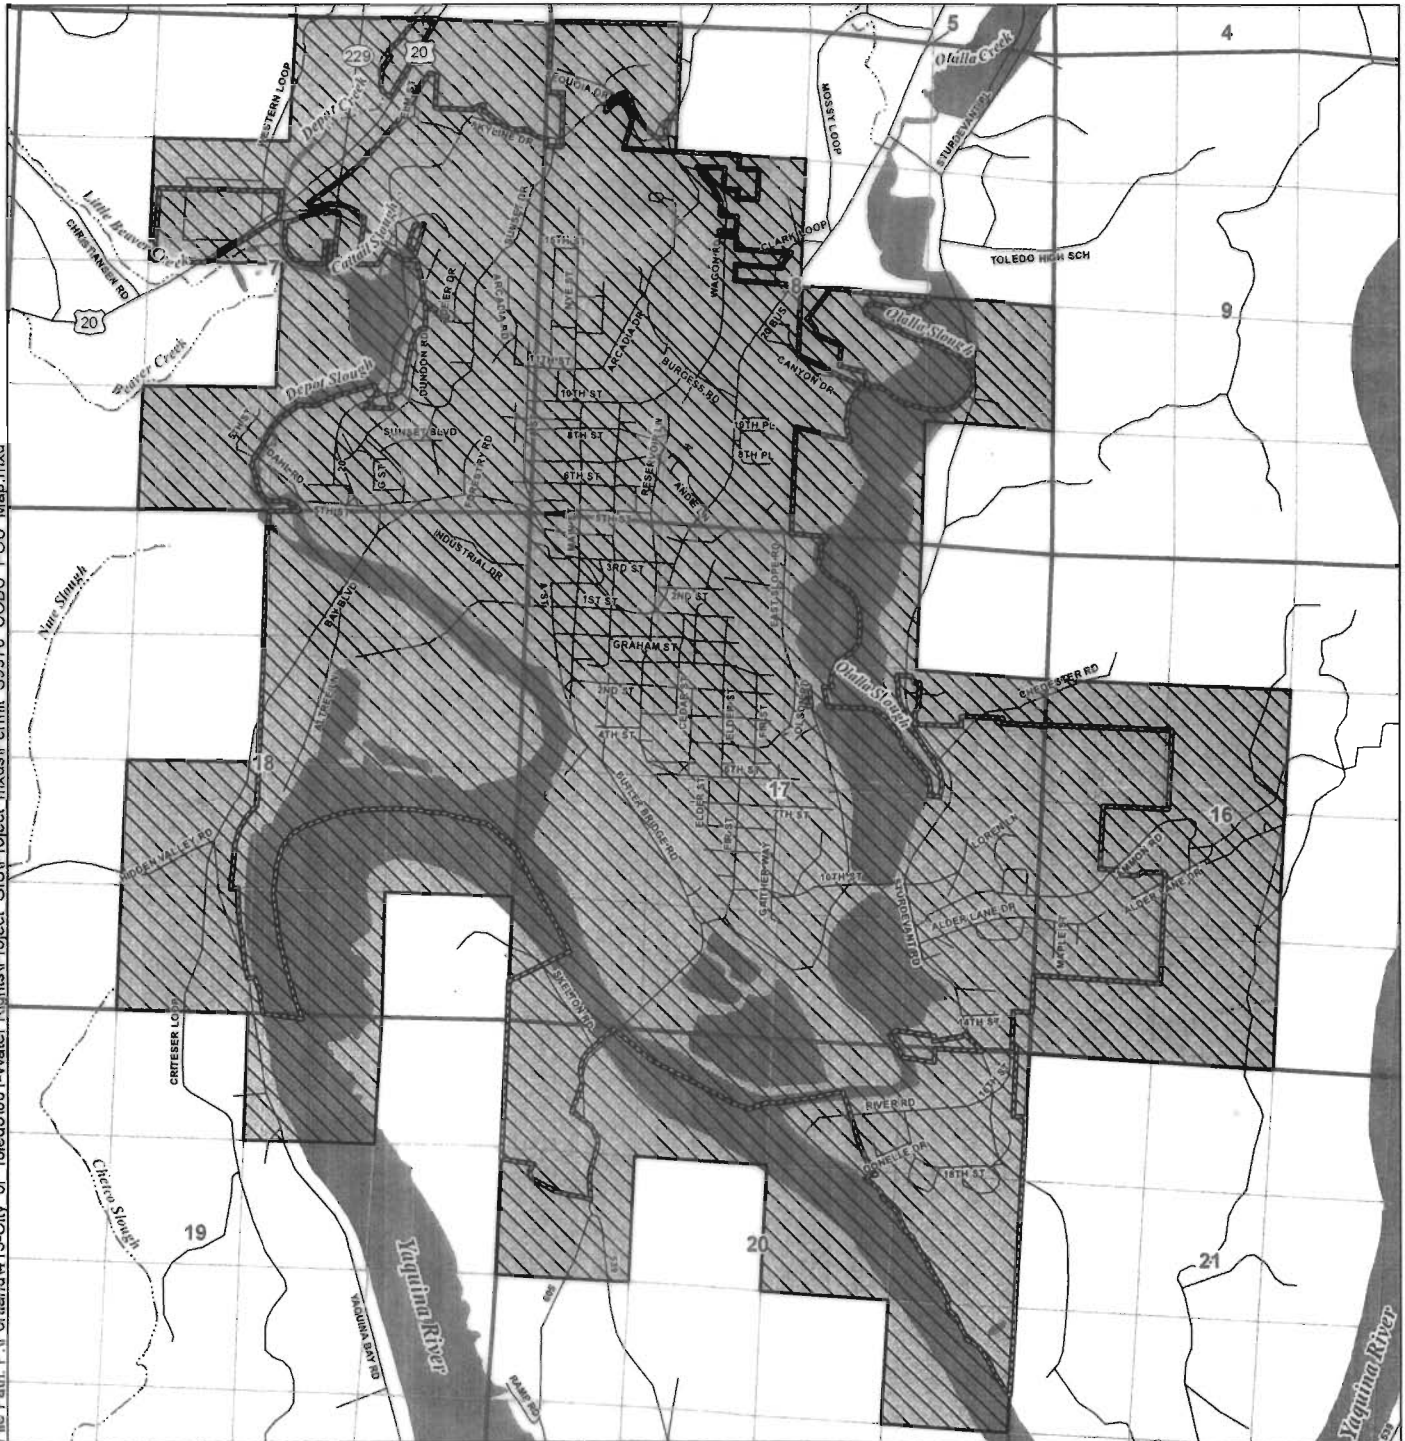

LEGEND

- Place of Use (POU)
- Toledo City Limits
- Roads
- Watercourses
- Waterbodies

Certified Water Rights Examiner Stamp

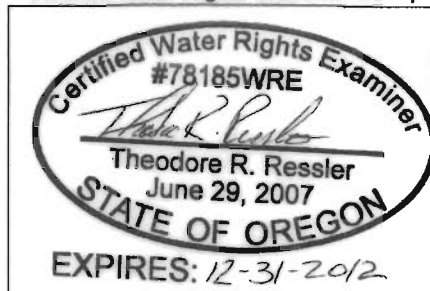

Disclaimer

This map was prepared for the purpose of identifying the location of a water right only and it is not intended to provide legal dimensions or location of property ownership lines

Map Notes

Date: September 29, 2011
 Data Sources: OWRD, US BLM, OGIC, ESRI
 Prepared By: GSI Water Solutions, Inc.




0 1,000 2,000
 1 inch = 2,000 feet



Claim of Beneficial Use Place of Use Map Water Right in the Name of City of Toledo

Permit S-9370, Application S-9834

Townships 10 South, Range 10 West (W.M.)

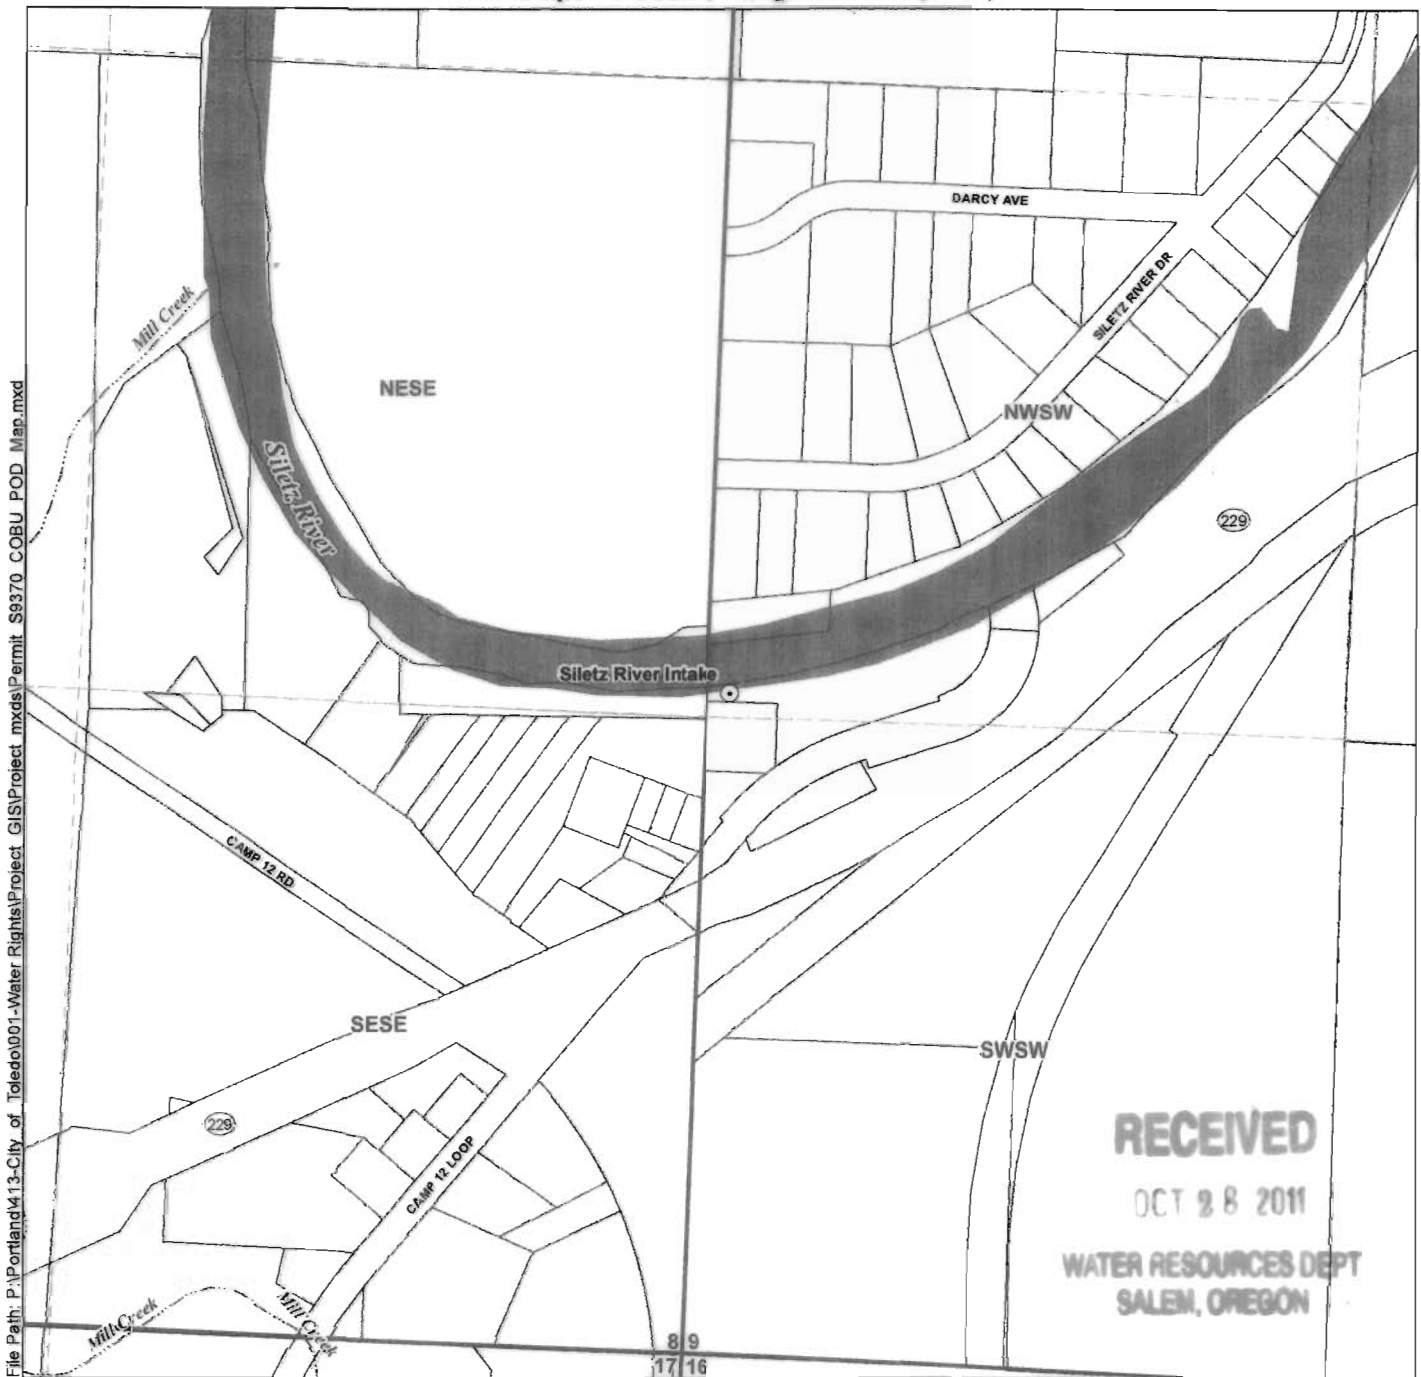


LEGEND

- Point of Diversion (POD)
- Tax Lots
- Watercourses
- Waterbodies

POD Location Description

Siletz River Intake
Located 1,380 feet North and 50 feet East from the SW corner of Section 9, Township 10 South, Range 10 West (W.M.)

Certified Water Rights Examiner Stamp

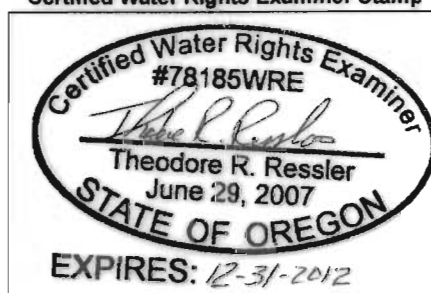

Disclaimer

This map was prepared for the purpose of identifying the location of a water right only and it is not intended to provide legal dimensions or location of property ownership lines.

Map Notes

Date: October 6, 2011
Data Sources: OWRD, OGIC, US BLM
Prepared By: GSI Water Solutions, Inc.

