

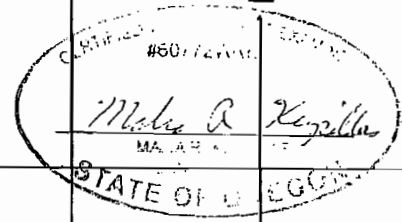
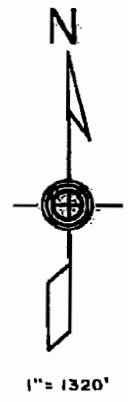


Townships 5 & 6 South, Range 1 West, W.M.
 Portions of Sections 33, 34 & 35 in Township 5 South
 & Sections 2 & 3 & the East 1/2 of Section 4 in Township 6 South

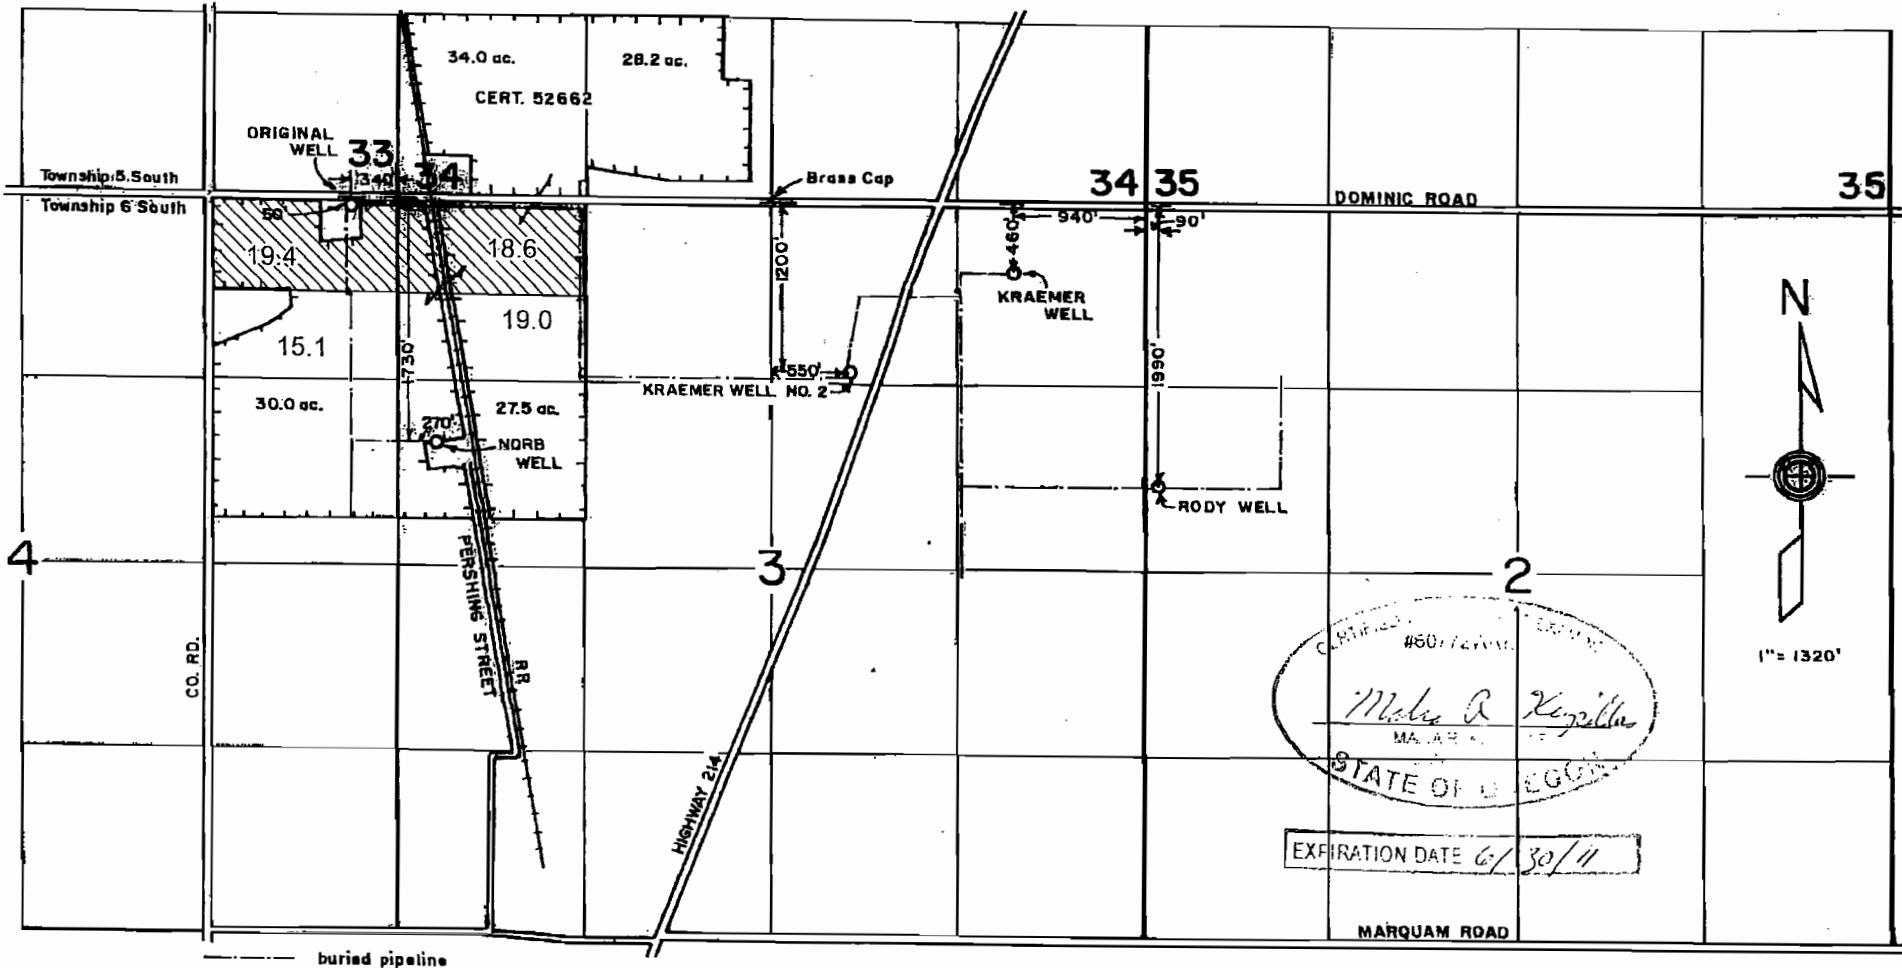


EXPIRATION DATE 6/30/11

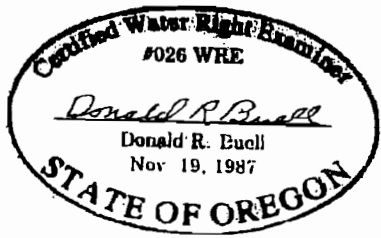

RECEIVED
FEB 12 1997
 WATER RESOURCES DEPT
 SALEM, OREGON

FINAL PROOF SURVEY
 under
Transfer 6381
 in name of
KRAEMER FARMS
 Jan. 23, 1997

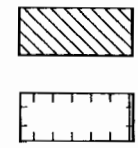

James C. Ruef LLC
 Kraemer Farms

REC 07 2009

THIS MAP WAS PREPARED FOR THE PURPOSE OF IDENTIFYING THE LOCATION OF A WATER RIGHT ONLY AND IS NOT INTENDED TO PROVIDE LEGAL DIMENSIONS OR LOCATION OF PROPERTY OWNERSHIP LINES.