


CLAIM OF BENEFICIAL USE AND FINAL PROOF MAP

FOR
GLEN AND REBECCA HALVORSON

T40S, R13E, Sec. 23 & 26, W.M.
KLAMATH COUNTY, OREGON

APPLICATION No. G-12885
PERMIT No. G-12455

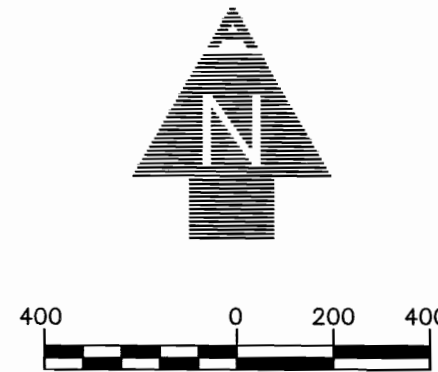

NOTES:

1. THIS MAP WAS PREPARED FROM FIELD MEASUREMENTS, NAIP 2005 AERIAL PHOTOGRAPH, KLAMATH COUNTY TAX MAPS 4013 & INDEX, 401326 AND OREGON GLO MAPS.
2. THE PURPOSE OF THIS MAP IS TO IDENTIFY THE LOCATION OF THE WATER RIGHT ONLY, AND IS NOT INTENDED TO PROVIDE DIMENSIONS OR LOCATION OF PROPERTY LINES.
3. FOR TAX LOT INFORMATION, SEE TAX MAPS INCLUDED WITH THIS APPLICATION.
4. DATE OF PRIORITY FOR THIS APPLICATION IS APRIL 20, 1992.
5. ALL PIPES SHOWN ON THE MAP ARE BURIED UNLESS OTHERWISE NOTED.


WELL TIE: 172' SOUTH AND 2,037' WEST
OF THE NE CORNER SECTION 26, T40S,
R13E, W.M.

D/C LOT	1/4 1/4	SECTION	TOWNSHIP	RANGE	PERMITTED PRIMARY ACRES	PERMITTED SUPPLEMENTAL ACRES	IRRIGATED PRIMARY ACRES	IRRIGATED SUPPLEMENTAL ACRES
	SW SE	23	40S	13E	17.4		17.4	1.1
	SE SE	23	40S	13E		36.6		35.6
	NE NE	26	40S	13E		38.8		38.2
	NW NE	26	40S	13E	20.0	2.8	19.4	2.7
	SE NW	26	40S	13E	2.2		1.8	
	SE NE	26	40S	13E		39.8		37.8
	SW NE	26	40S	13E	23.0	7.6	24.0	8.5
	NW SE	26	40S	13E		2.5		2.0
	NE SE	26	40S	13E		36.9		34.9
TOTAL ACRES :					62.6	165.0	62.6	160.8

LEGEND

- TOTAL ACRES IRRIGATED PER 1/4 1/4 IRRIGATED PRIMARY LANDS THIS CLAIM OF BENEFICIAL USE 1/4 1/4 SECTION
- IRRIGATED SUPPLEMENTAL LANDS THIS CLAIM OF BENEFICIAL USE
- SECTION DESIGNATION
- TAX LOT NUMBER
- EXISTING WELL 1 AND FLOW METER
- DIRECTION OF FLOW
- 10" PVC MAIN LINE SIZE & MATERIAL
- PIVOT LINE
- SECTION LINES
- 1/4 1/4 LINES
- ROADS
- PROPERTY BOUNDARY
- TAX LOT BOUNDARY
- WATER BOUNDARY

Rebecca Halvorson
Applicant signature

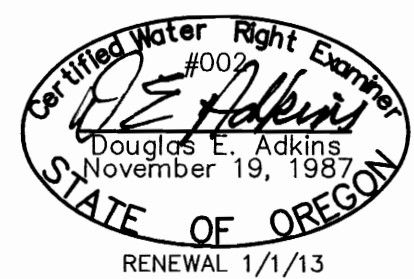

2950 Shasta Way · Klamath Falls, Oregon 97603 · (541) 884-4666 · FAX (541) 884-5335
Klamath Falls, OR · Medford, OR · Alturas, CA

COBU MAP #0654