



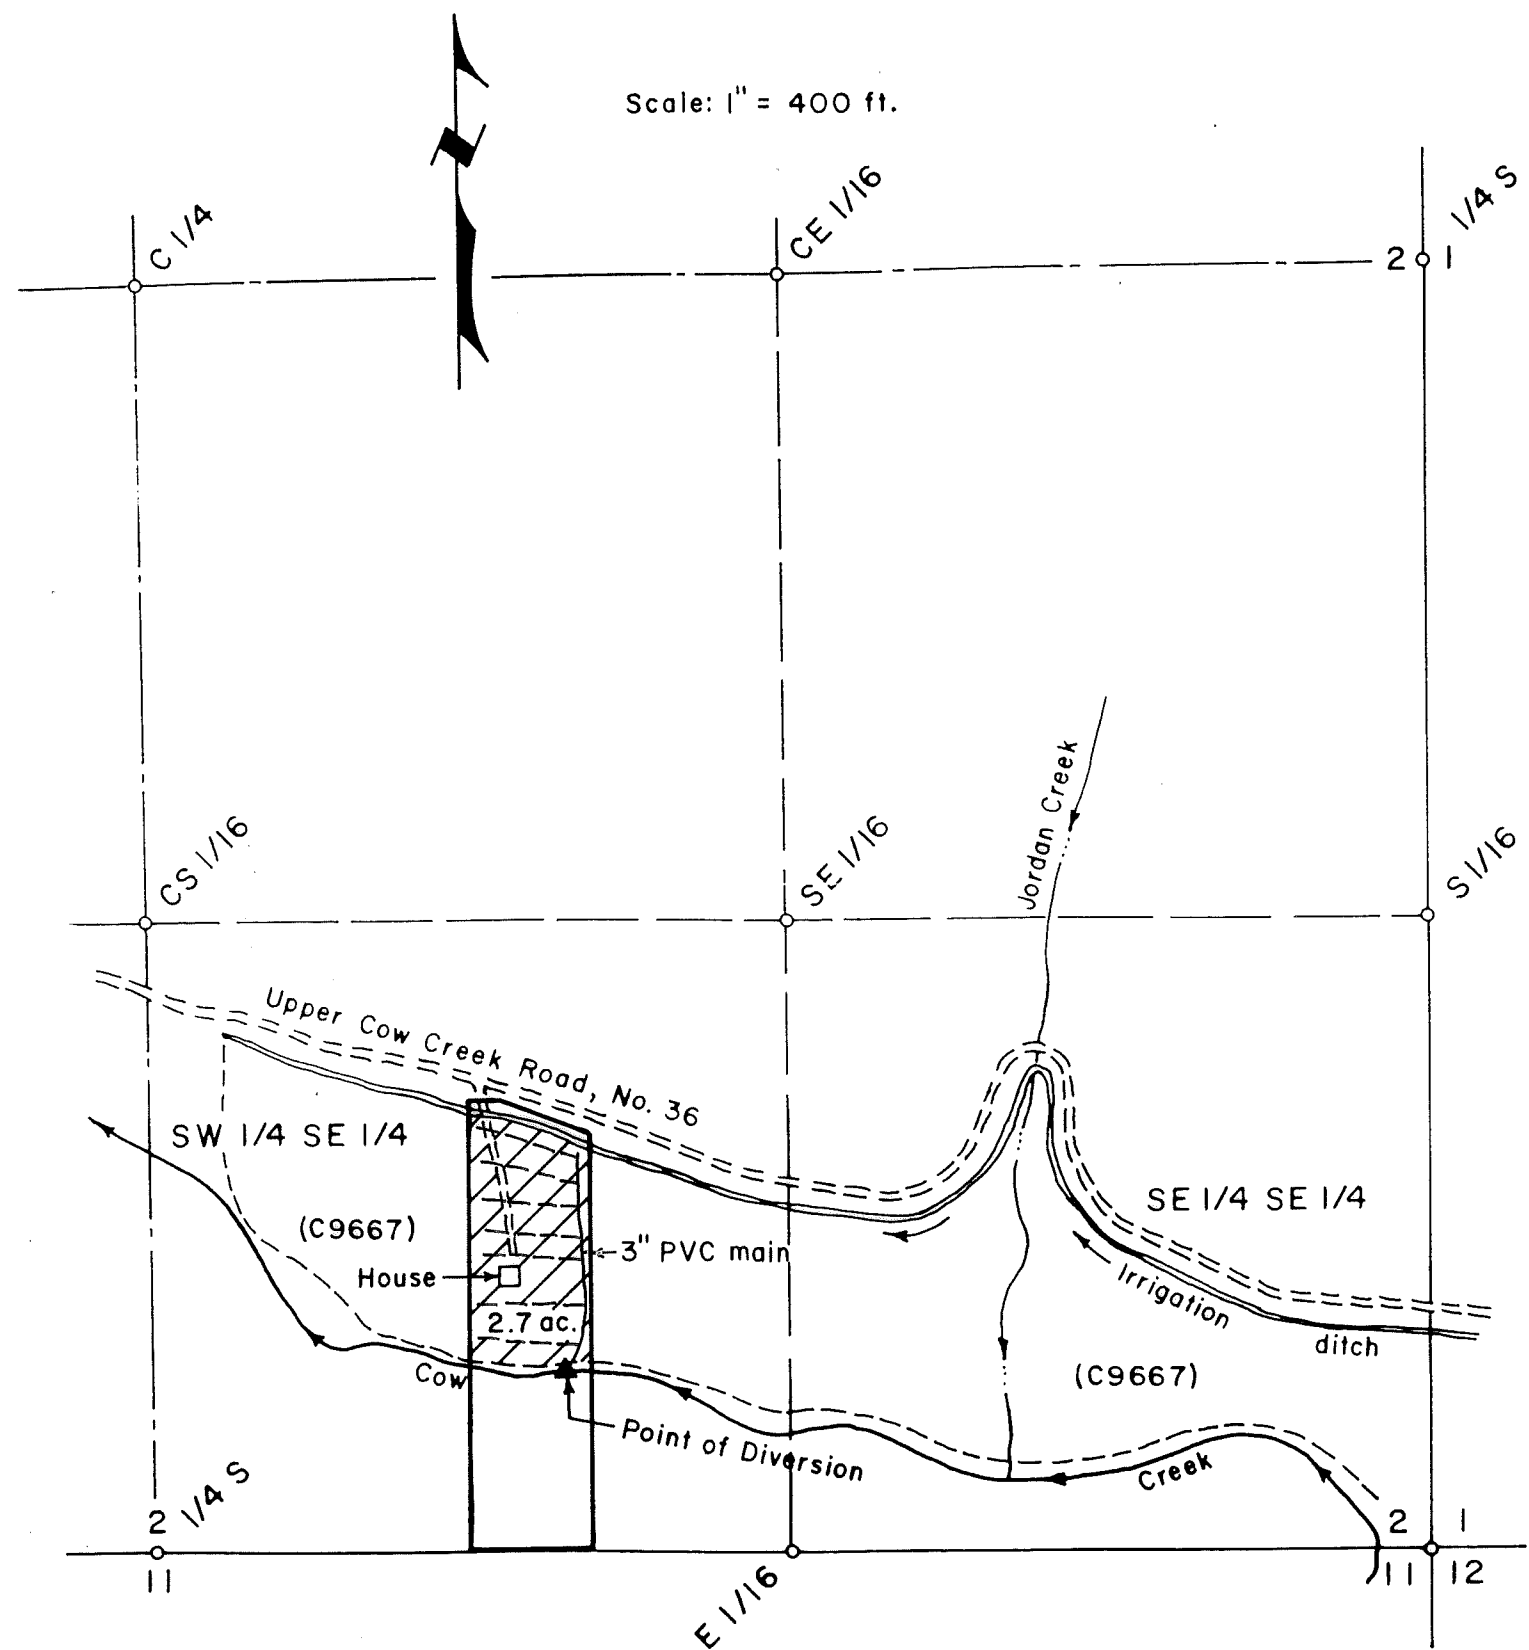

Point of diversion is 370 ft. North
& 850 ft. East of the South 1/4
Corner of Section 2.

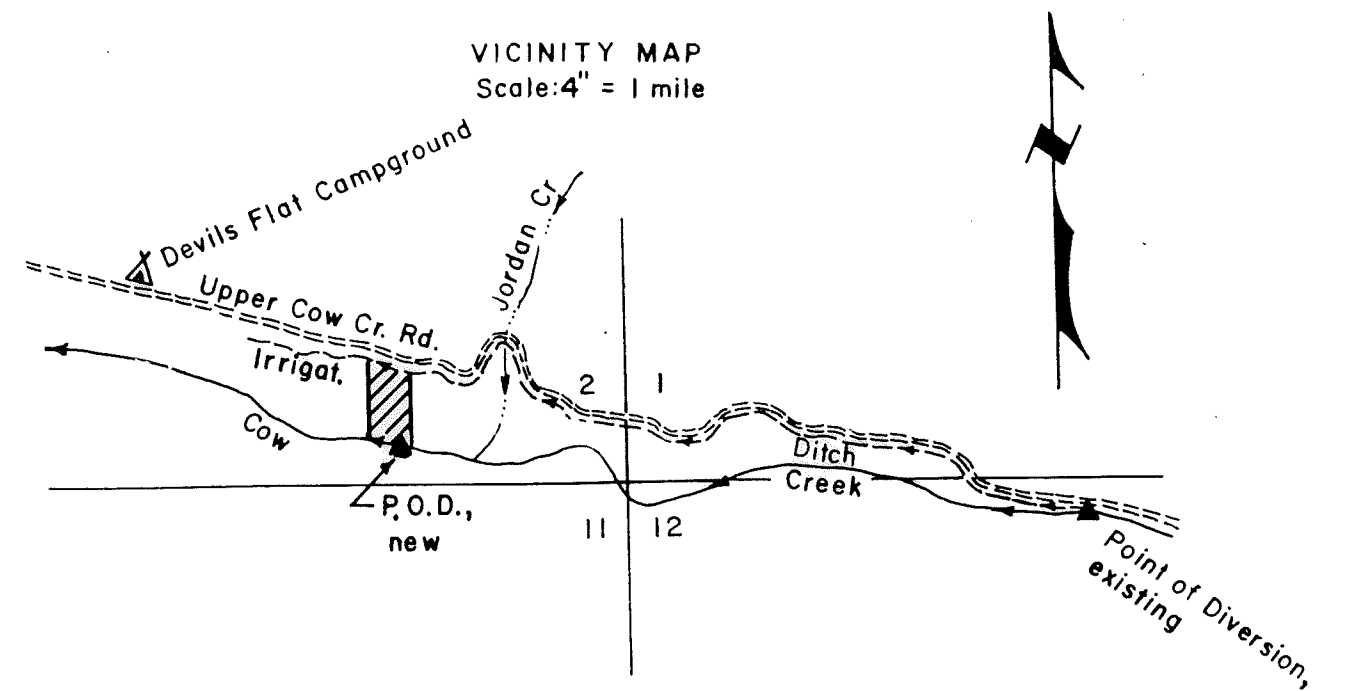

RECEIVED
DEC 09 1998
WATER RESOURCES DEPT.
SALEM, OREGON

FINAL PROOF SURVEY OF A
POINT OF DIVERSION TRANSFER,
COW CREEK, SE 1/4 OF SECTION 2, T32S,
R3W, W.M., DOUGLAS COUNTY, OREGON
Transfer No. 7695
Water Right Certificate No. 9667

For: James P. & Marilyn R. Pack
2802 Stonebrook Drive
Medford, Oregon 97504

By: Shaner Engineering, Inc.
P.O. Box 1430
Roseburg, Oregon 97470

November 30, 1998

