




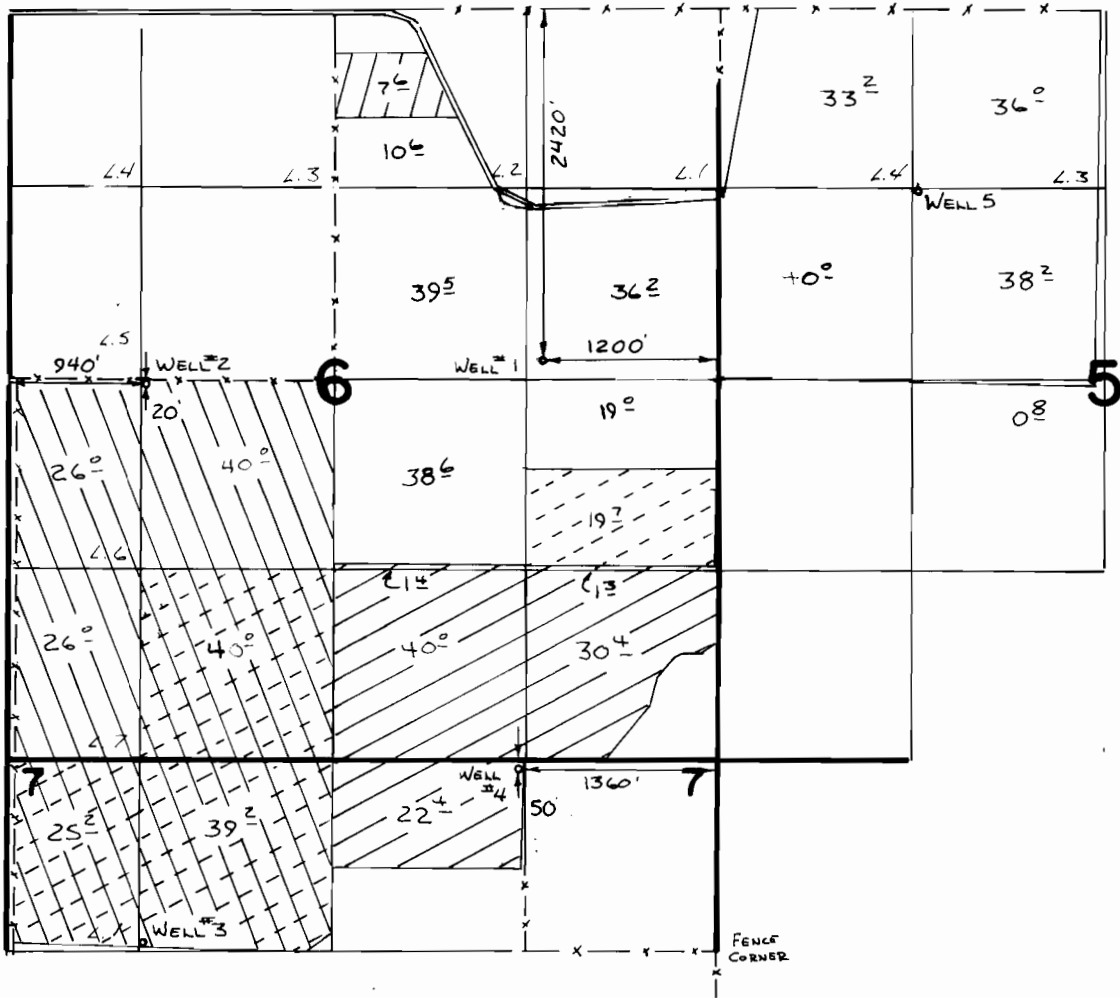

T. 26S., R. 34E., W.M.



-  WELL #2 PRIM (G-7547)
-  WELL #1 PRIM (G-8269)
-  WELL #4 PRIM (G-8269)
-  WELL #4 SUPPL (G-8269)



SCALE 1" = 1320'

FINAL PROOF SURVEY UNDER

G-8720 G-8269
 Application No. G-8096 Permit No. G-7547
 IN NAME OF

.....
 Surveyed 5-10 1988, by V.L. Church.....