






# T. 26S., R. 34E., W.M.

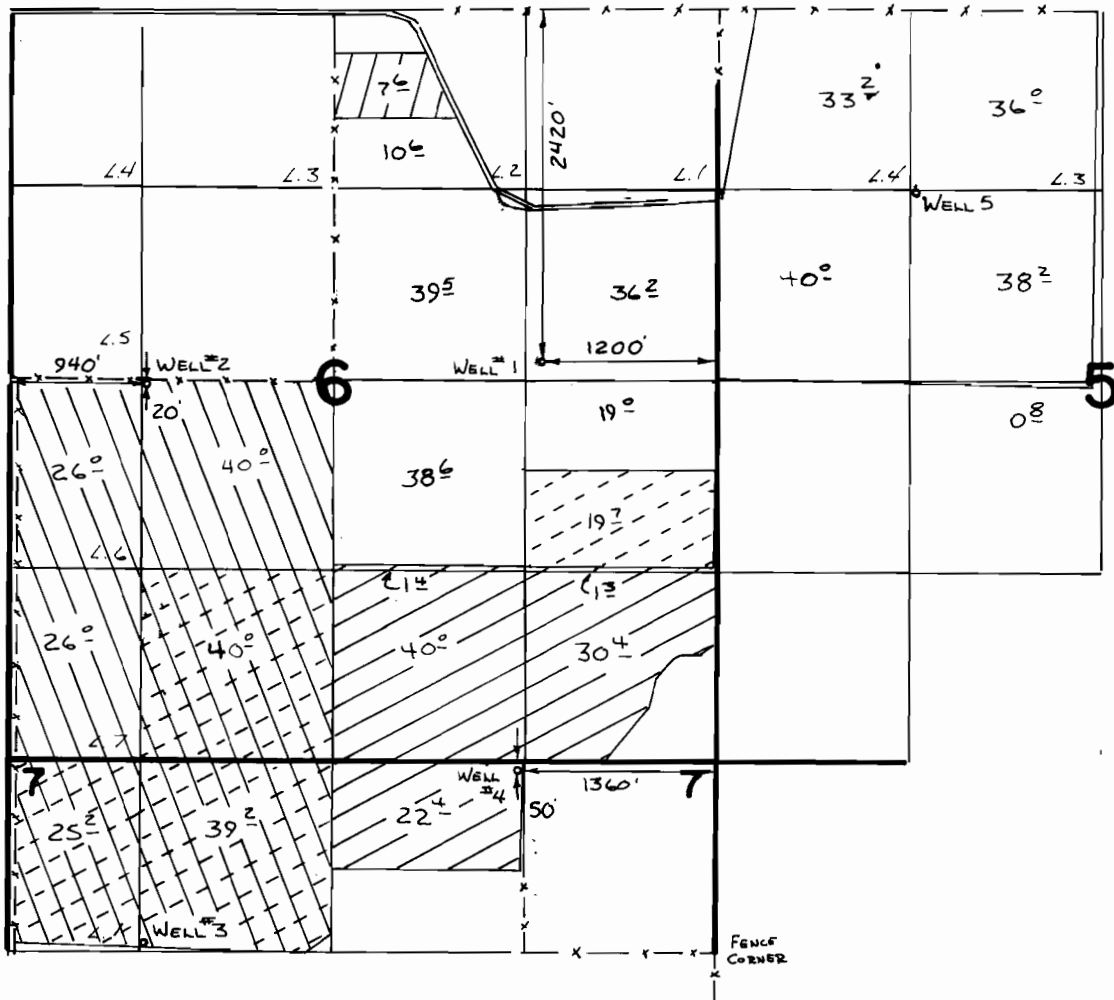

-  WELL #2 PRIM (G-7547)
-  WELL #1 PRIM (G-8269)
-  WELL #4 PRIM (G-8269)
-  WELL #4 SUPPL (G-8269)



SCALE 1" = 1320'

## FINAL PROOF SURVEY

UNDER

G-8720                      G-8269

Application No. ~~G-8096~~ Permit No. ~~G-7547~~...

IN NAME OF

.....

Surveyed ~~5-10~~..... 1988, by ~~V.L. Church~~.....