


RECEIVED



This drawing is an exhibit for a Final Proof Survey. It is not a Land Survey. Property lines and/or other lines of occupation shown hereon are not represented by the undersigned to meet accuracy standards of Land Surveys.

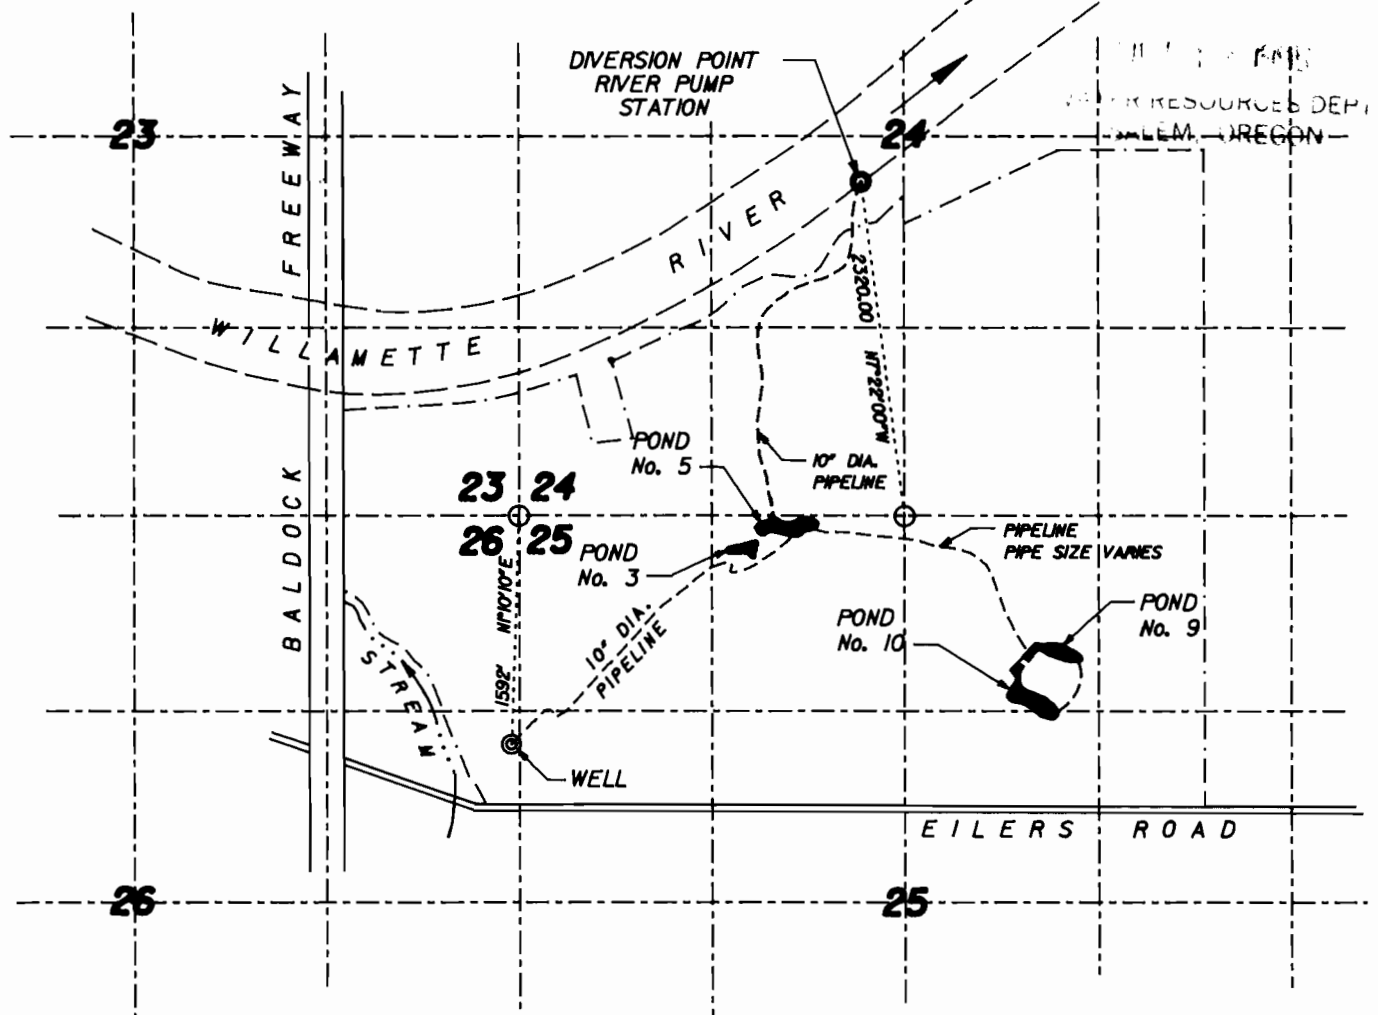


SCALE: 4" = 1 MILE

**SECTIONS 24, 25 & 26, T.3S., R.1W., W.M.
CLACKAMAS COUNTY, OREGON**

Certified Water Rights Examiner
#056
J. H. Greenman
J. H. Greenman
Nov. 19, 1987
STATE OF OREGON
95/10/13

Application No. **G-12146**
Permit No. **G-11532**

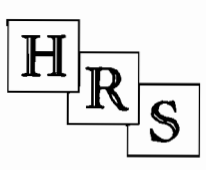

**HANER, ROSS &
SPORSEEN, INC.**
15 S.E. 82ND DRIVE
GLADSTONE, OREGON 97027

FINAL PROOF SURVEY
IN NAME OF
CHARBONNEAU GOLF CLUB, INC.

9/19/95 edf c:\u\m\h\dm\612g