



WATER RIGHT TRANSFER T-6984

FINAL PROOF MAP

U.S.G.S. QUADS - WINNEMUCCA CREEK & MOSQUITO MOUNTAIN, OREG. - 7 1/2'
PORTIONS OF SECTIONS 13, 23 & 24, T.23S., R.37E., W.M.

LEGEND

	ROAD
	CHANNEL
	RAILROAD GRADE
	TRAIL
	FENCE
	PIPELINE
	BUILDING
	FOUND CORNER ON U.S.G.S. QUAD
	FOUND CORNER GPS LOCATION
	IRRIGATED AREA
	FORMER IRRIGATED AREA
	DIVERSION POINT
	TAX LOT

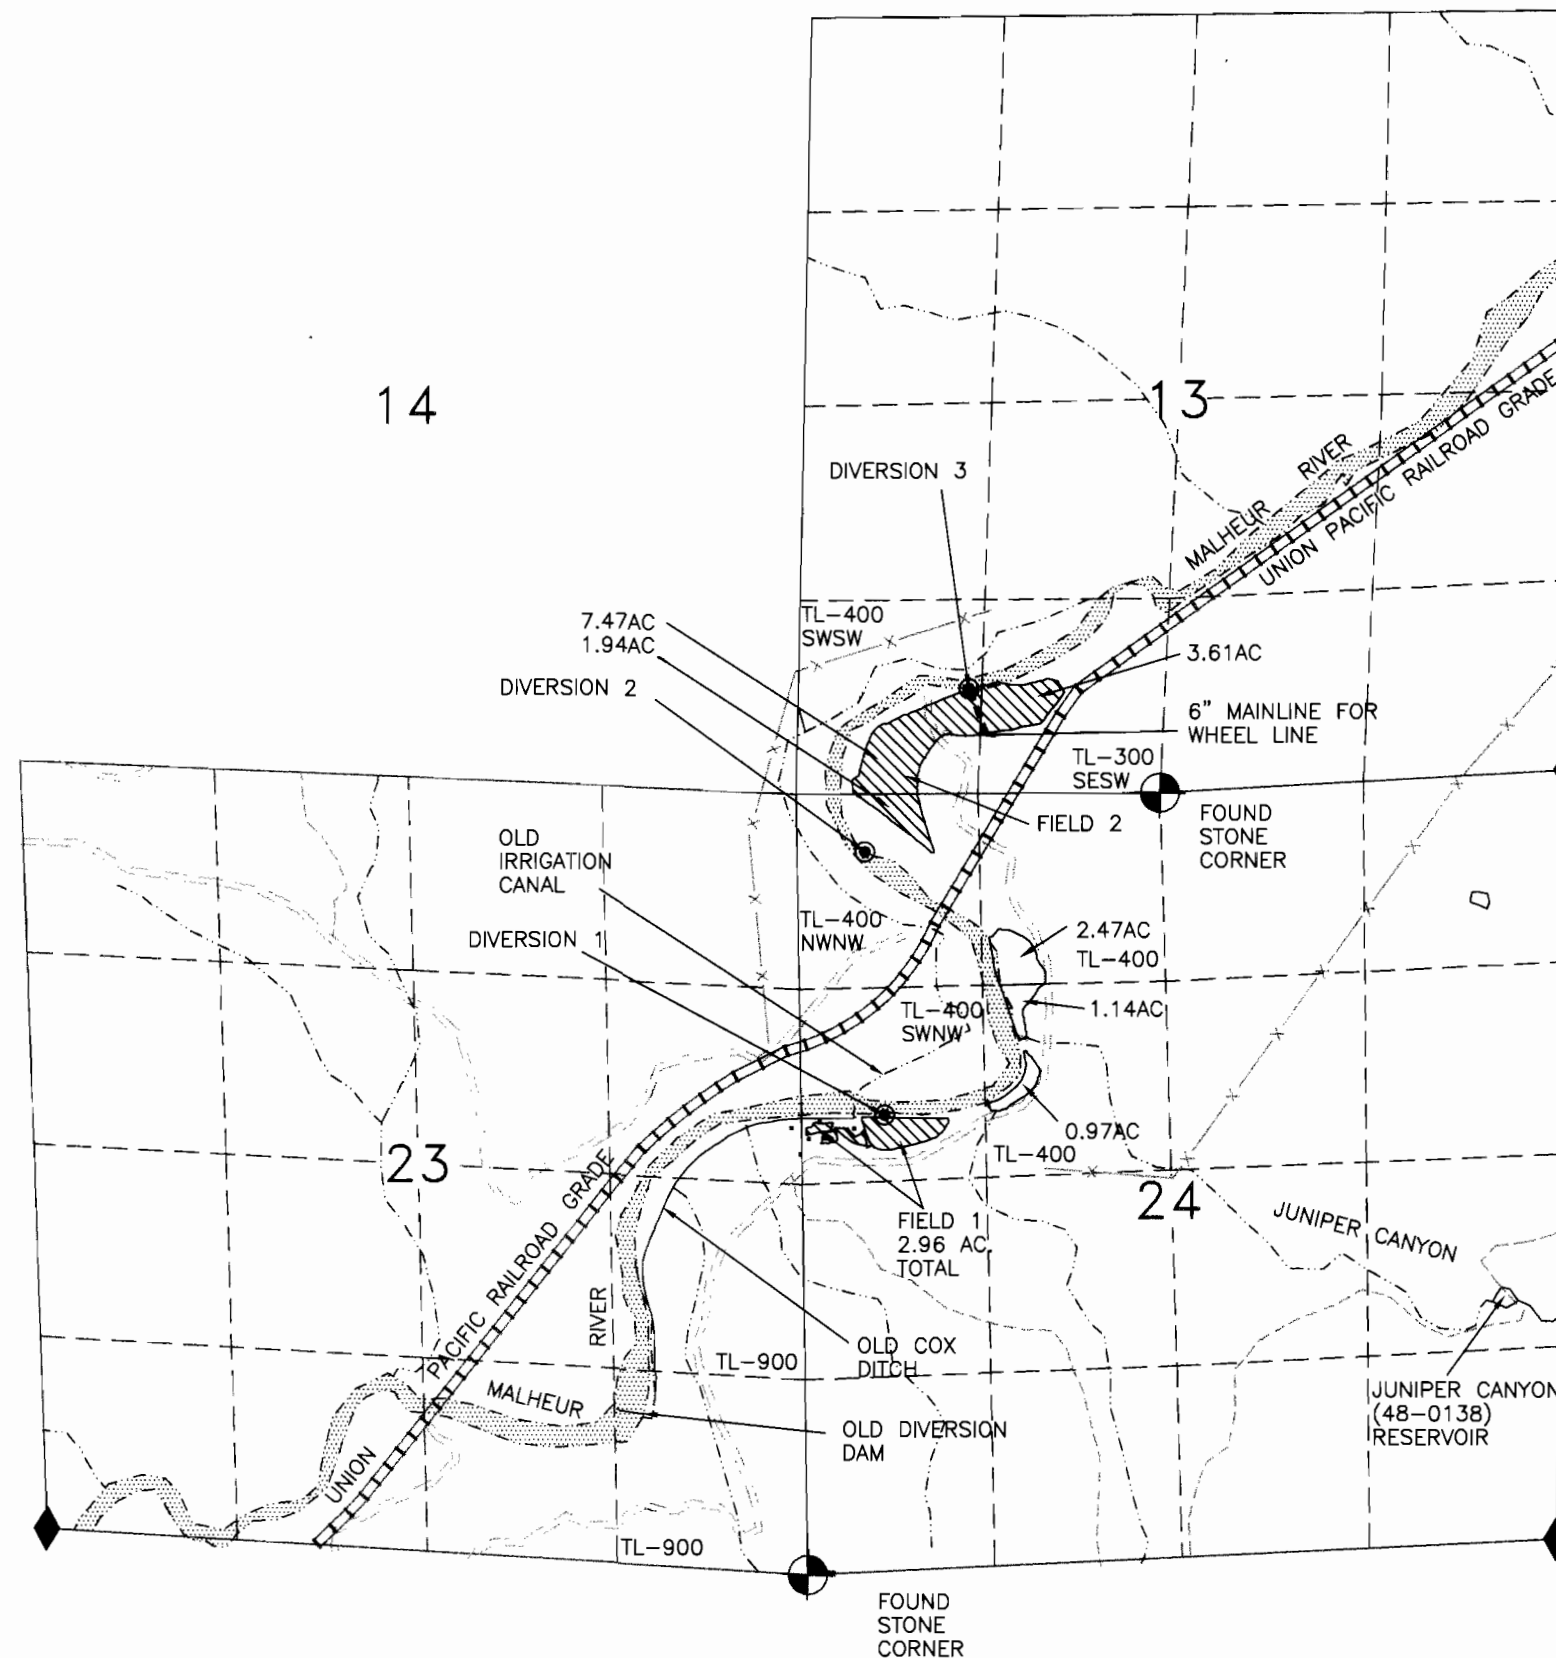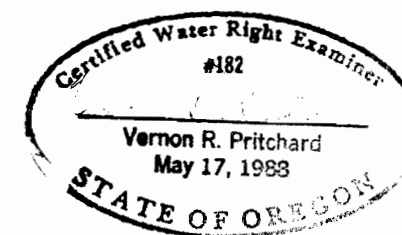

DISTANCE FROM THE N1/4 COR SECTION 24, T.23S., R.37E., W.M.			
DIVERSION 1	SW1/4 NW1/4 SECTION 24	2209' SOUTH	1889' WEST
DIVERSION 2	NW1/4 NW1/4 SECTION 24	406' SOUTH	2030' WEST
DIVERSION 3	SW1/4 SW1/4 SECTION 13	712' NORTH	1316' WEST

NOTES:

- THIS MAP IS FOR THE PURPOSE OF LOCATING A WATER RIGHT AND IS NOT INTENDED TO PROVIDE LEGAL DIMENSIONS FOR LOCATION OF PROPERTY BOUNDARIES
- DISTANCES SHOWN IN THE TABLE WERE CALCULATED FROM GPS FIELD SURVEYS.
- SECTION 13:
TAX LOT 300 - STATE OF OREGON
TAX LOT 400 - OREGON DEPARTMENT OF FISH & WILDLIFE
SECTION 23:
TAX LOT 400 - OREGON DEPARTMENT OF FISH & WILDLIFE
TAX LOT 900 - STATE OF OREGON
SECTION 24:
TAX LOT 400 - OREGON DEPARTMENT OF FISH & WILDLIFE
- THE AREA BELOW THE CANAL SHOWN ON THE NORTH & WEST SIDE OF THE RIVER WAS PREVIOUSLY IRRIGATED THROUGH A SUSPENDED PIPE LOCATED NEAR DIVERSION #1.

1320 660 0 1320

SCALE 1"=1320'



REV. NO.	DESCRIPTION	DATE	APPROVED
UNITED STATES DEPARTMENT OF THE INTERIOR BUREAU OF LAND MANAGEMENT			
DIVISION OF OPERATIONS		VALE DISTRICT	
OREGON DEPT. OF FISH & WILDLIFE FINAL PROOF MAP			
TRANSFER T-6984			
DESIGNED			
REVIEWED			
APPROVED			
DRAWN: C.G.	SCALE: 1"=1320'		
DATE: 9/29/97	SHEET 1 OF 1		
DRAWING NO. OR-03-9172.1005			