

RECEIVED


T. 3S., R. 25E., W.M.

MORROW COUNTY

SCALE 1" = 1320'

SEP 26 1997

WATER RESOURCES
SALEM, OREGON

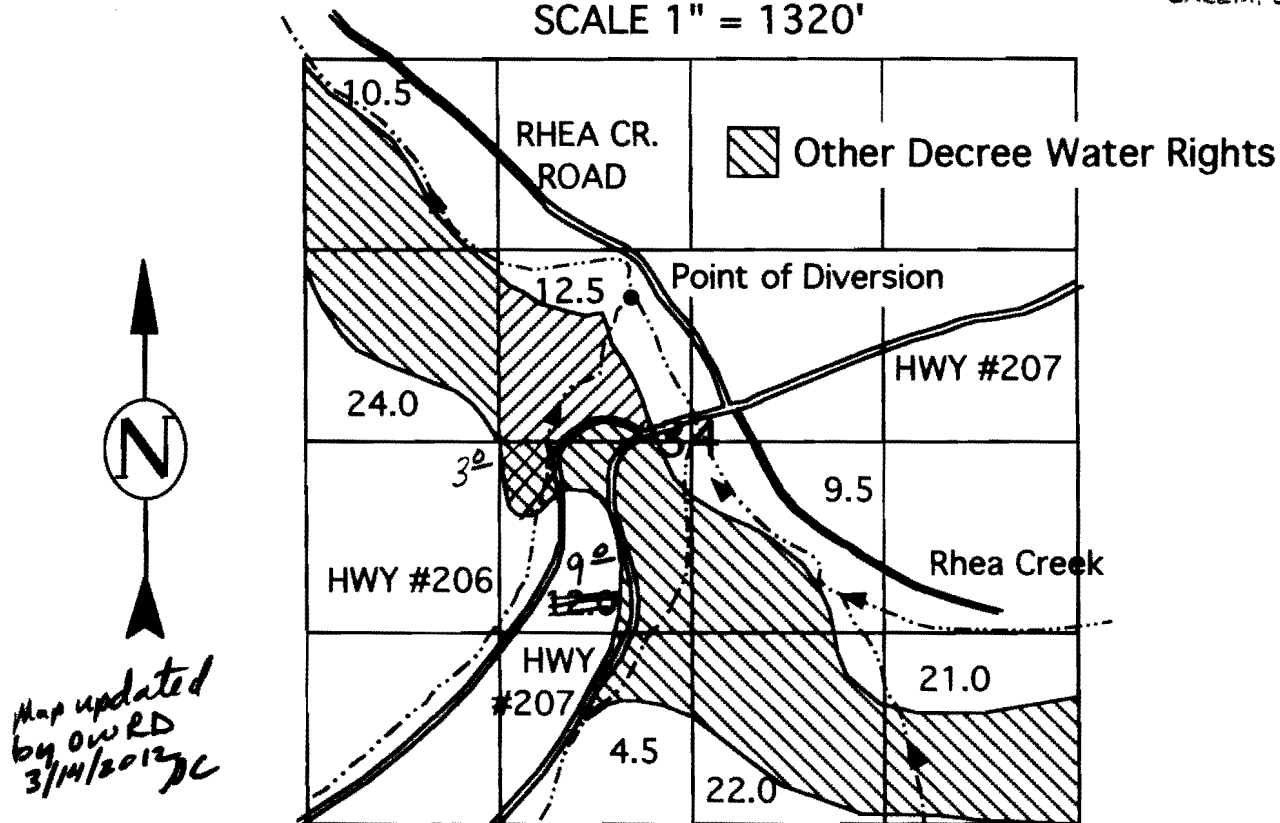

Map shows all Willow Creek/Rhea Creek Decree Water Rights for the Section
Point of Diversion Located 1200' North & 790' West of Center of Section 34


WATER RIGHTS PROOF MAP

Decree Water Rights at This Location

IN NAME OF

Crescent Creek Company

THIS MAP IS FOR THE PURPOSE
OF IDENTIFYING THE LOCATION
OF WATER RIGHTS ONLY AND IS
NOT INTENDED TO PROVIDE THE
LEGAL DIMENSIONS OR LOCATIONS
OF PROPERTY OWNERSHIP LINES.

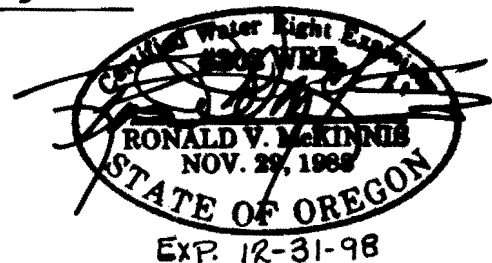

ENGINEERING - SURVEYING - WATER RIGHTS

R V McKINNIS ENGINEERING

Rt 1 Box 1122 Hermiston, Oregon 97838

541-567-2017