


T.7 & 8 S., R.1W., W.M

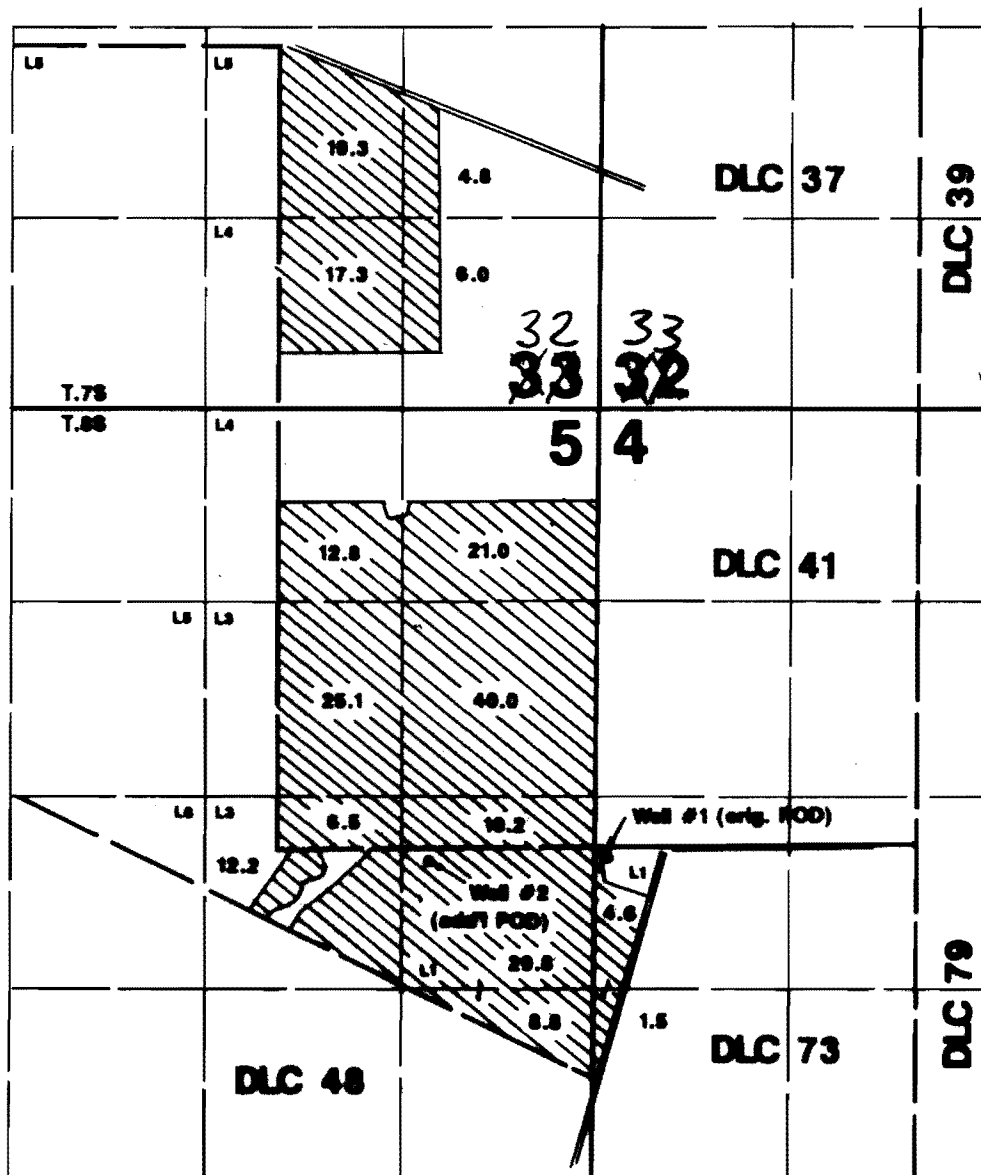

Well # 1 (orig POD) is located 2240'N & 80'E from SW corner Section 4.
Well # 2 (add'l POD) is located 2210'N & 1130'E from SW corner Section 4.

Final Proof Survey

Transfer #: T-6856

In Name Of

Charles D. Wavera

Surveyed on February 27, 1998 by JM Schuette

RECEIVED

MAR 17 1998

WATER RESOURCES DEPT.
SALEM, OREGON

This Map Was Prepared For The Purpose Of Identifying The Location Of A Water Right Only And Is Not Intended To Provide Legal Dimensions Or Location Of Property Ownership Lines.

