


T 6 S, R 1 W, WM

MARION COUNTY

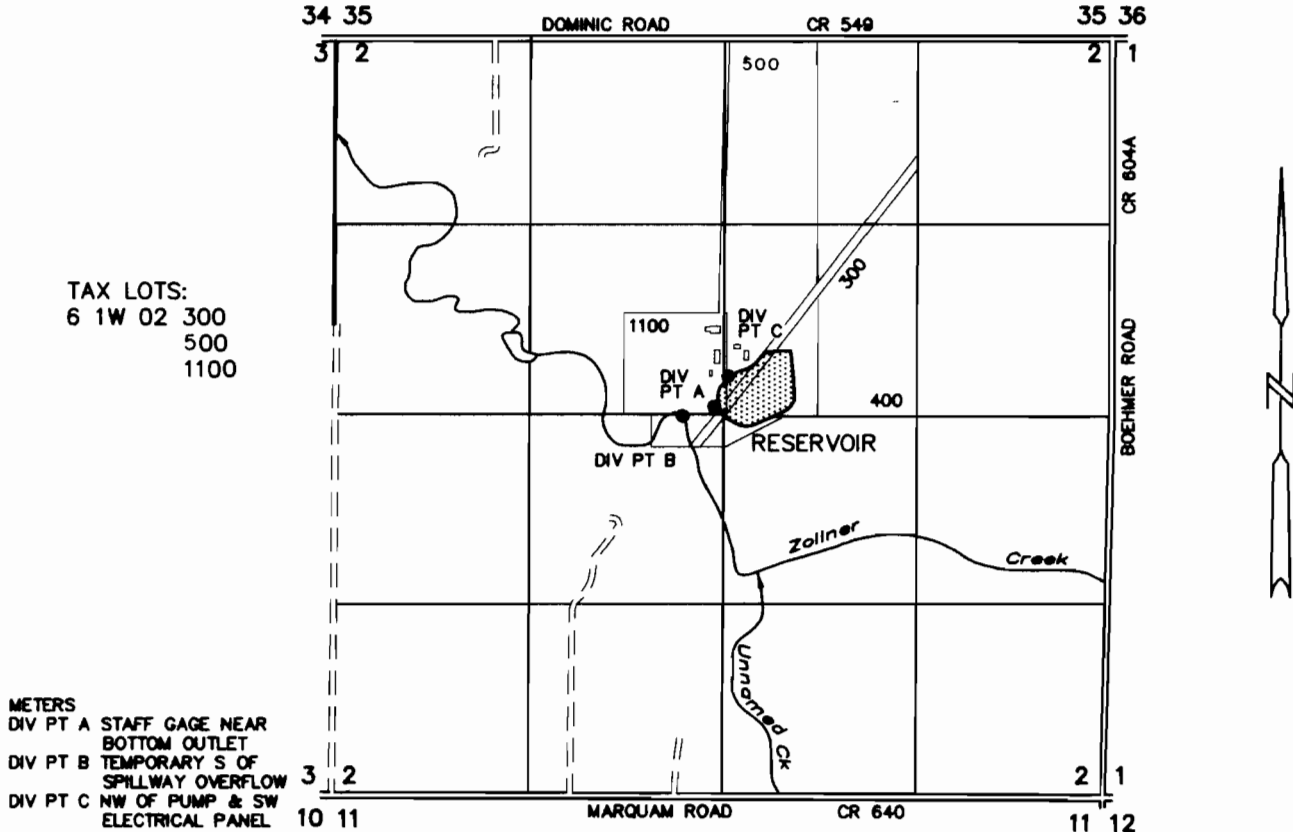

TAX LOTS:
6 1W 02 300
500
1100

METERS
DIV PT A STAFF GAGE NEAR
BOTTOM OUTLET
DIV PT B TEMPORARY S OF
SPILLWAY OVERFLOW
DIV PT C NW OF PUMP & SW
ELECTRICAL PANEL

SCREEN ATTACHED TO END OF
INTAKE PIPE AT DIV PT B

DAM DIV PT A: 2570' S & 65' W OF THE N 1/4 COR OF SEC 2
CREEK DIV PT B: 2635' S & 275' W OF THE N 1/4 COR OF SEC 2
IRRIGATION DIV PT C: 2360' S & 30' E OF THE N 1/4 COR OF SEC 2

FINAL PROOF SURVEY

UNDER

Application No. R-86475 Permit No. R-14414
S-86476 S-54386

IN THE NAME OF

LEON BERNING

JULY 6, 2009
JANUARY 27, 2010
SCALE: 1" = 1320'



NOTE: This map is not intended to provide legal dimensions or locations of property ownership lines.

EXPIRES 12-31-11