


# T 6 S, R 1 W, WM

MARION COUNTY

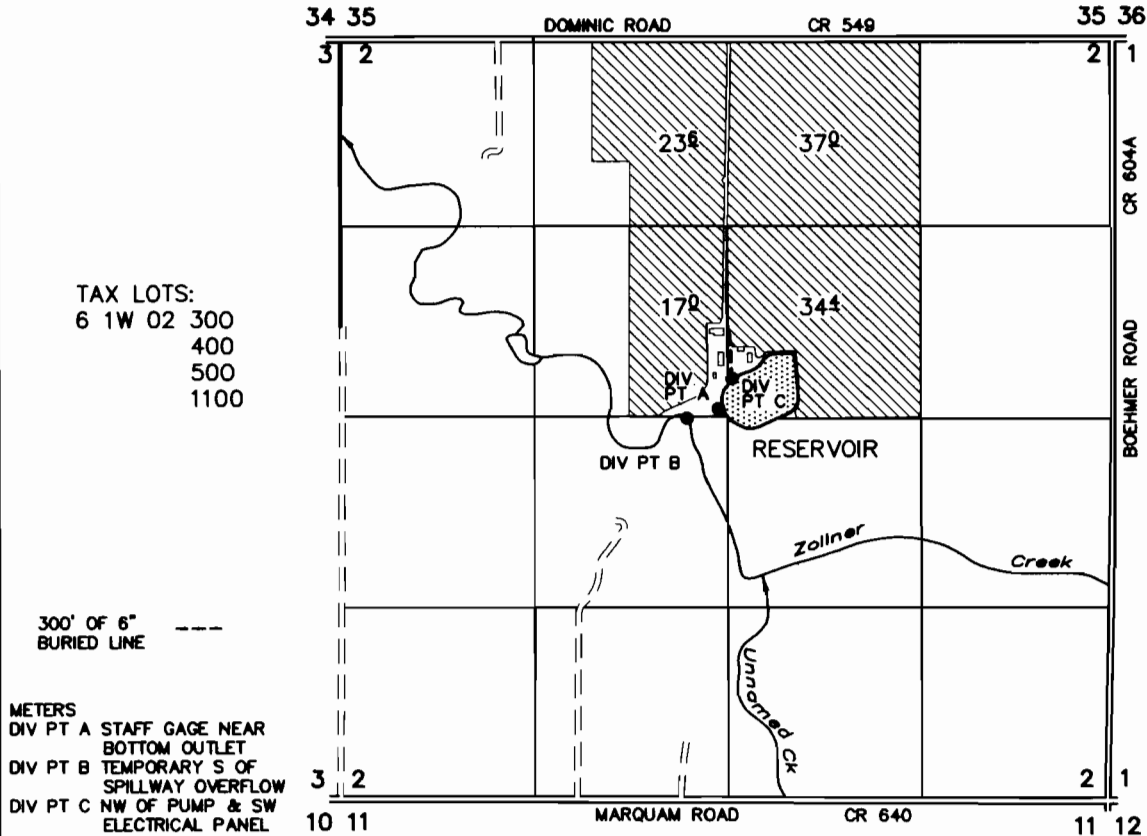

TAX LOTS:  
6 1W 02 300  
400  
500  
1100

300' OF 6" BURIED LINE

METERS  
DIV PT A STAFF GAGE NEAR  
BOTTOM OUTLET  
DIV PT B TEMPORARY S OF  
SPILLWAY OVERFLOW  
DIV PT C NW OF PUMP & SW  
ELECTRICAL PANEL

FISH SCREEN ON INTAKE AT  
DIV PT B ONLY

DAM DIV PT A: 2570' S & 65' W OF THE N 1/4 COR OF SEC 2  
CREEK DIV PT B: 2635' S & 275' W OF THE N 1/4 COR OF SEC 2  
IRRIGATION DIV PT C: 2360' S & 30' E OF THE N 1/4 COR OF SEC 2

## FINAL PROOF SURVEY


UNDER

Application No. R-86475 Permit No. R-14414  
S-86476 S-54386

IN THE NAME OF

### LEON BERNING

JANUARY 27, 2010  
SEPTEMBER 24, 2010  
SCALE: 1" = 1320'

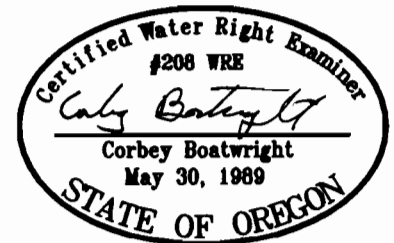

NOTE: This map is not intended to provide legal dimensions or locations of property ownership lines.

EXPIRES 12-31-11