


T.5S.R.1E.W.M.

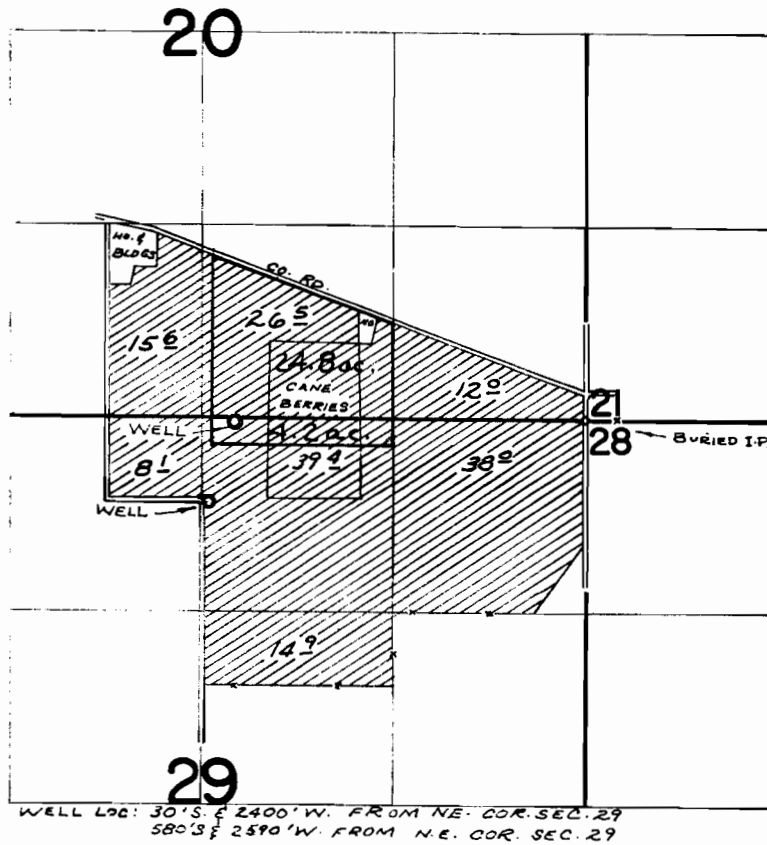

FINAL PROOF SURVEY UNDER

G-4763 G-4487
Application No. G-3133 Permit No. G-2069
IN NAME OF

JOHN BECK

Surveyed APR. 6, 1971 by R. MUCKEN...

*Part to be
canceled*