


THIS FINAL PROOF MAP REVISED FEBRUARY 21, 2012

FINAL PROOF SURVEY FOR JOHN BAKOS

DAM AND RESERVOIR UNDER PERMIT #R-11412
SUPPLEMENTAL IRRIGATION UNDER PERMIT #51326
LOCATED IN SECTIONS 35 AND 36, T40S, R33E, W.M.
AND IN SECTIONS 2 AND 11, T41S, R33E, W.M.
HARNEY COUNTY, OREGON

CURRENT PERMIT HOLDER EDNA READ

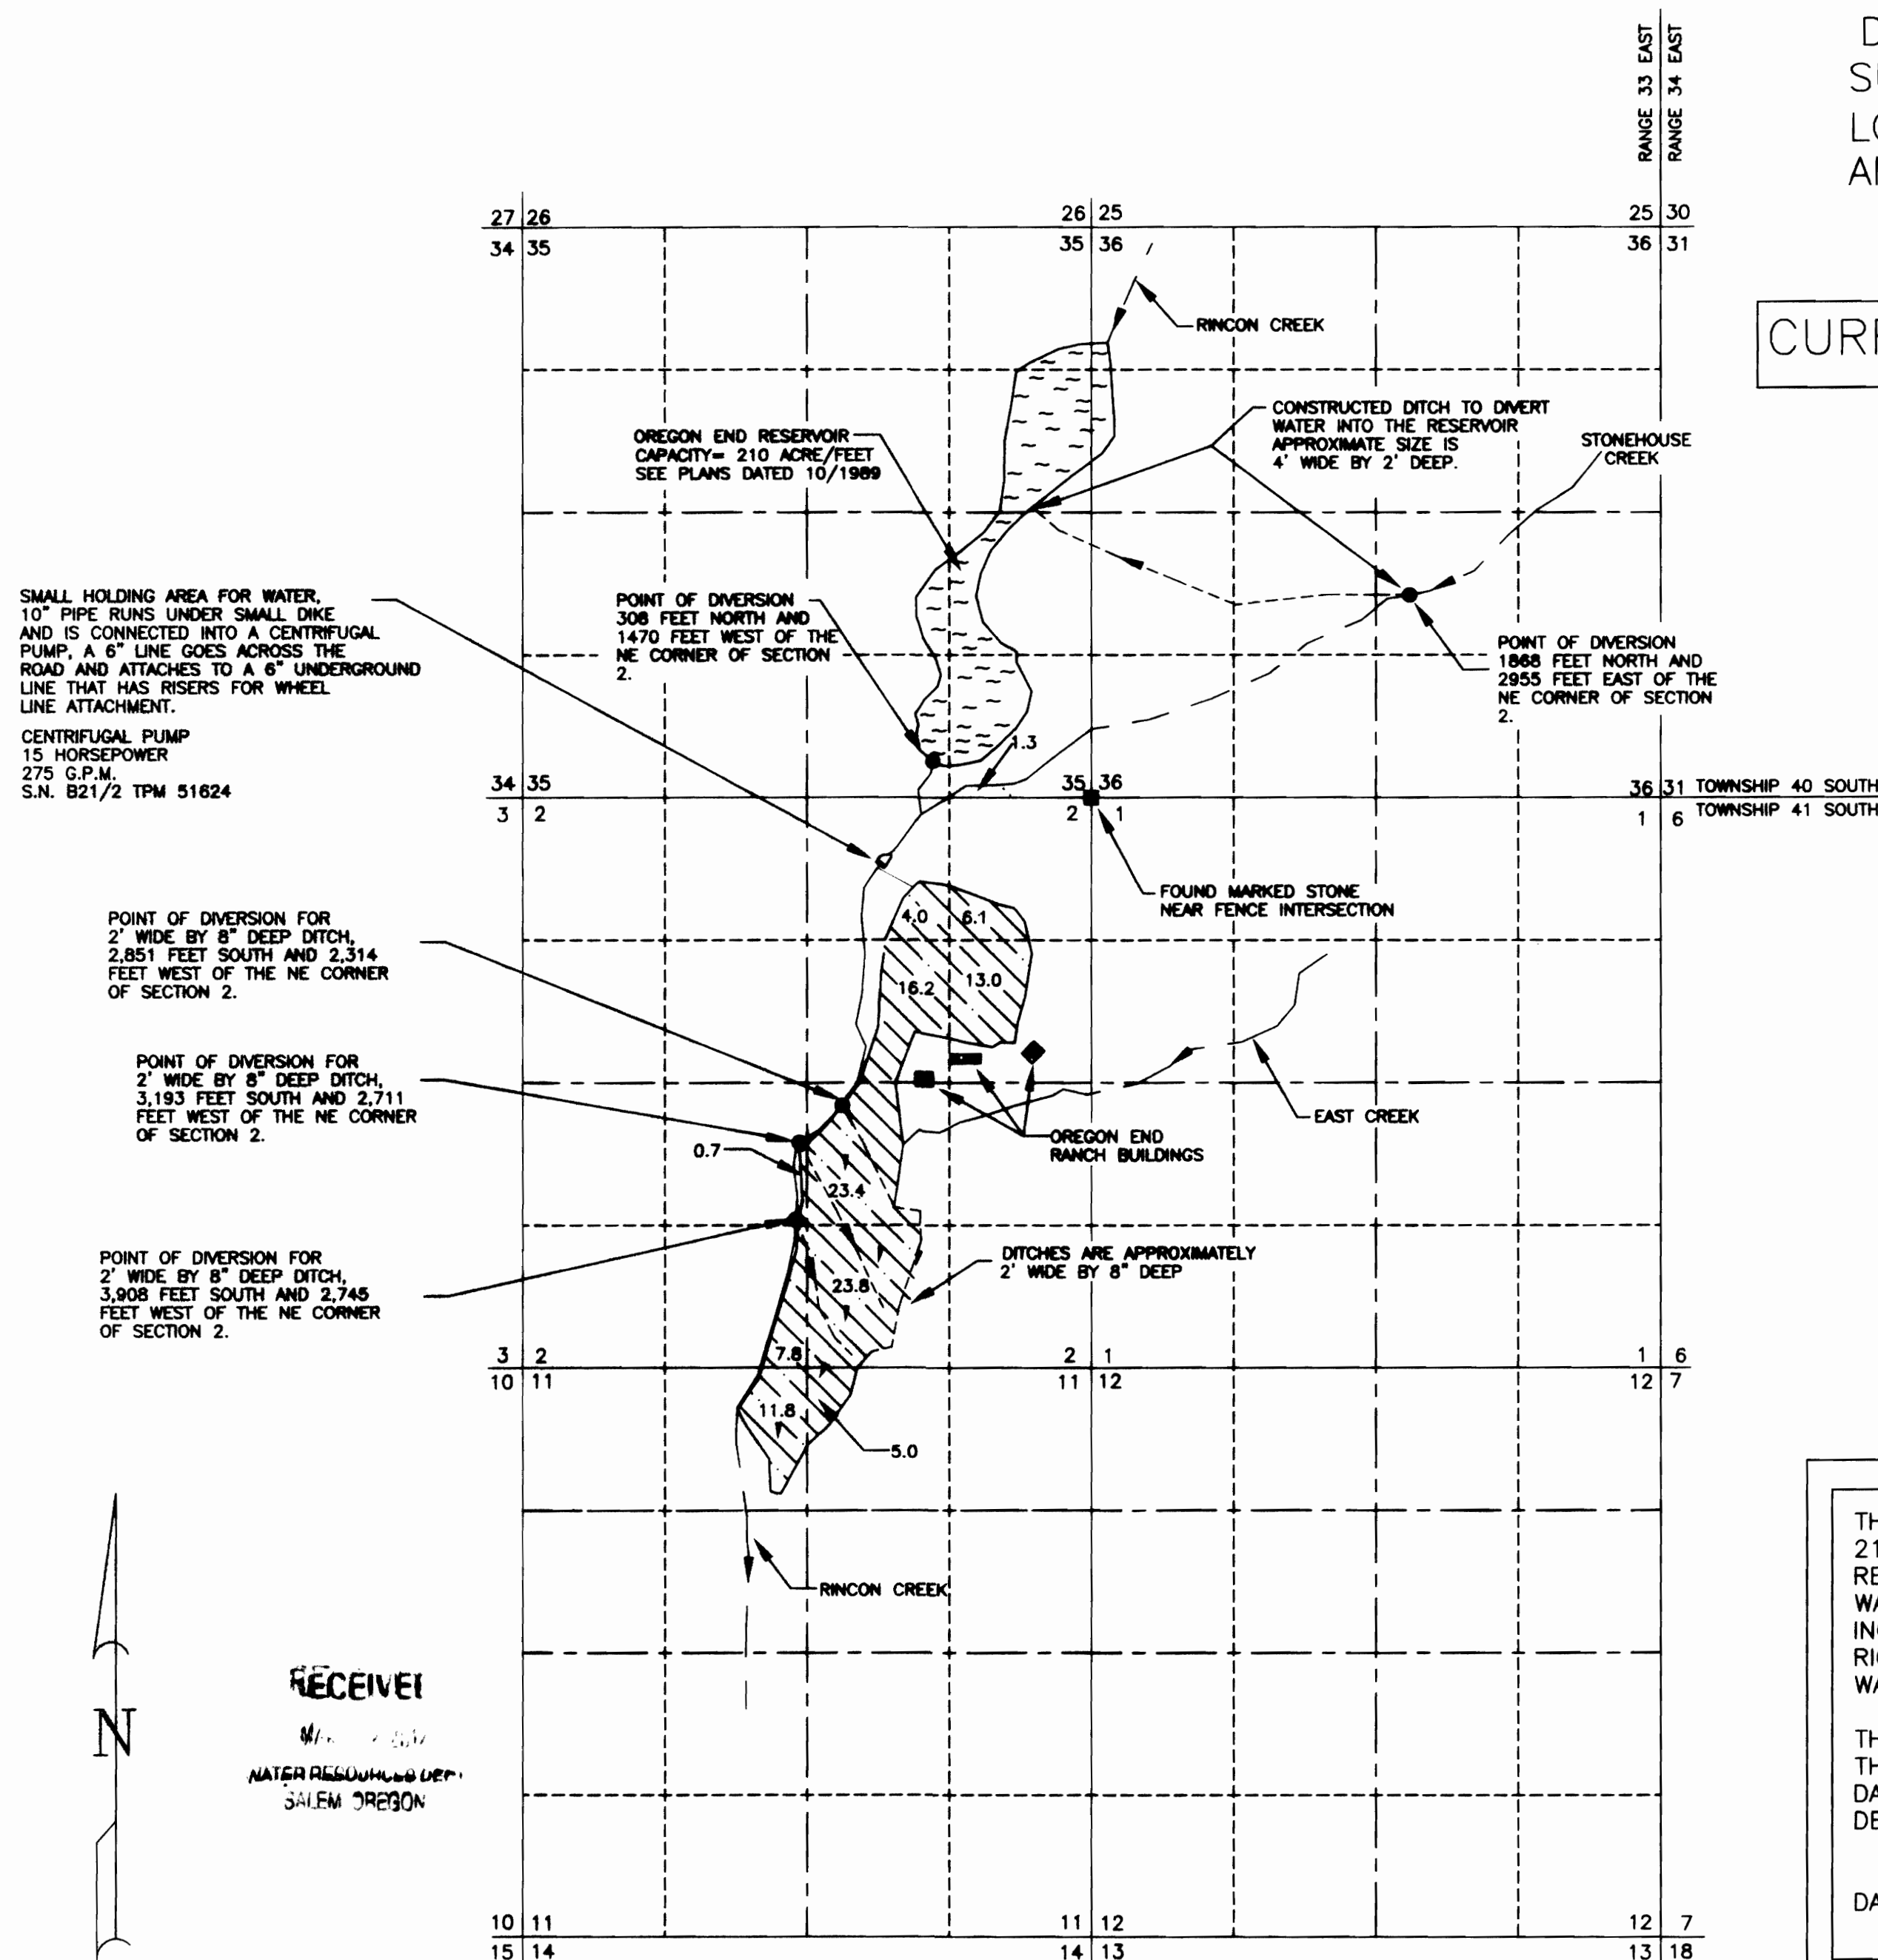


LEGEND

- SECTION LINE
- 1/4 SECTION LINE
- 1/16 SECTION LINE
- CREEK, NAME AS NOTED
- DITCH, SIZE AS NOTED
- DIVERSION POINTS AS NOTED
- DIRECTION OF FLOOD IRRIGATION
- FOUND MONUMENT AS NOTED
- OREGON END RESERVOIR
- SUPPLEMENTAL RIGHTS BEING IRRIGATED UNDER THIS PERMIT
PRIMARY RIGHT IS CERTIFICATE 44595
THE TOTAL ACREAGE BEING IRRIGATED IS 111.8 ACRES.
- BEARINGS BASED ON SOLAR OBSERVATION

THIS MAP REVISED AS PER FEBRUARY
21, 2012 AT THE REQUEST OF EDNA
READ, P.O. BOX 1406, GOLDENDALE,
WASHINGTON 98620. REVISIONS
INCLUDE AREAS TO MATCH PRIMARY
RIGHTS AS PER THE REQUEST OF THE
WATER RESOURCES DEPARTMENT

THIS MAP STILL ACCURATELY REFLECTS
THE WATER USE AS OF THE EXTENDED
DATE OF THIS PERMIT TO COMPLETE THE
DEVELOPMENT OF THIS PERMIT.

DARRYL ANDERSON CWRE 005

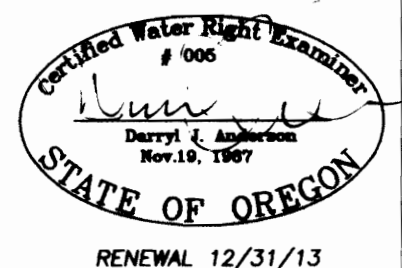

PREPARED FOR:
JOHN BAKOS
3805 HIGHWAY 65
LINCOLN, CA 95648
(916) 645-1616

PREPARED BY:
ANDERSON ENGINEERING AND SURVEYING
P.O. BOX 28
LAKEVIEW, OREGON 97630
(541) 947-4407 FAX 947-2321
JOB #94091 DRAWING: 94091
MAY 1995 SHEET 1 OF 1

SCALE: 1"=1320'

COBU MAP #684