


Sec. 337A
35 R 3 W

Sec. 4
T 4 S R 3 W

Tp 3 and 4 S

R. 3 W

Will. Mer.
Dre.

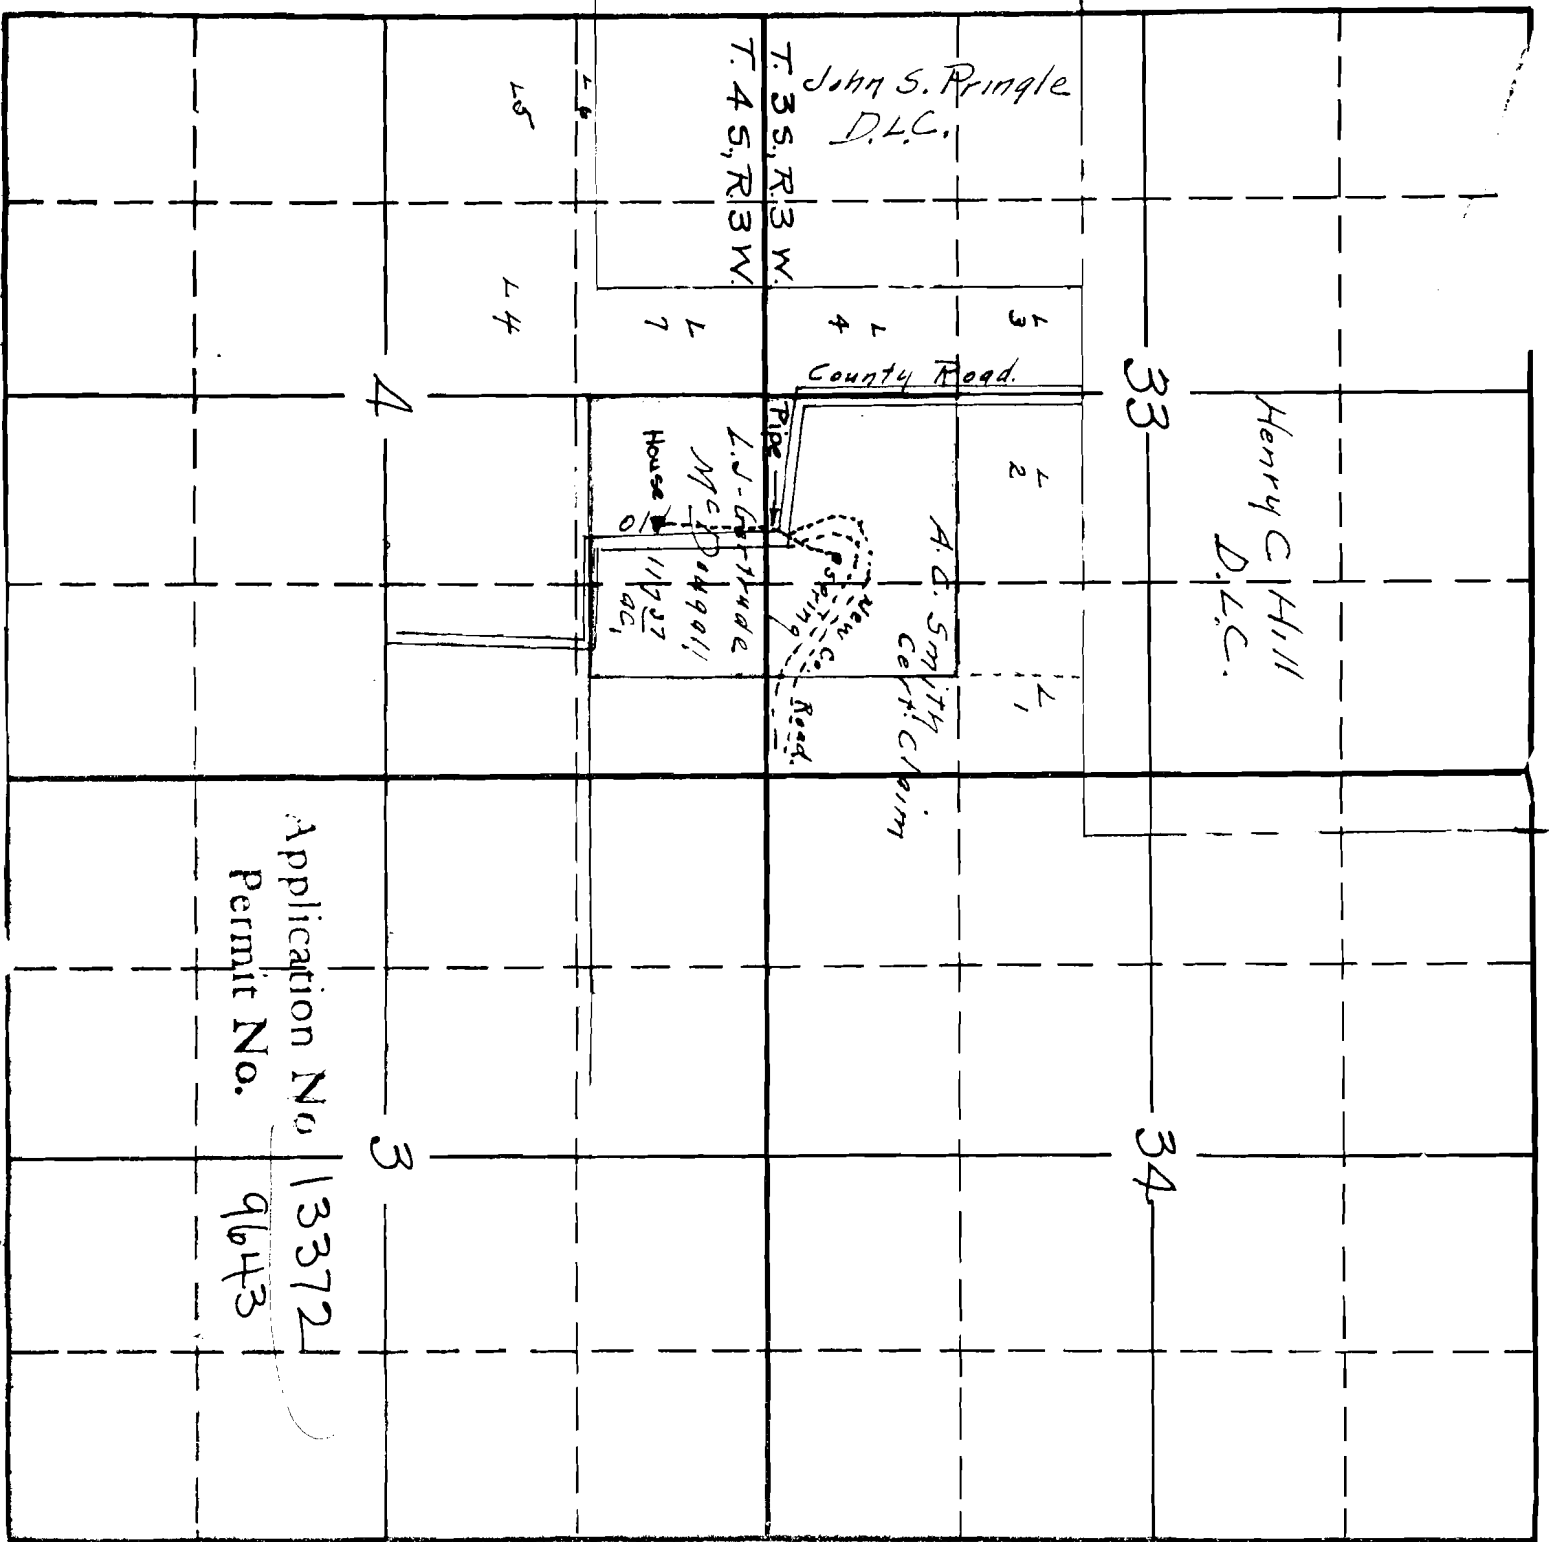

John S. Pringle
D.L.C.

T. 35, R. 3 W.
T. 4 S, R. 3 W.

33

Henry C Hill
D.L.C.

County Road.

L.J. G. Trade
McDonald
House

New Co. Road.
Pipe Spring

A.D. Smith
Cert. Claim

34

3

Application No 13372
Permit No. 9643