

COLUMBIA RIVER

T. 4 N., R. 25 E., W. M.

Div. Pt. C.I.D.

MAIN PUMP C.I.D.

NW 1/4 NE 1/4

NE 1/4 NE 1/4

Scale 1" = 400'


DIAT ROAD

T. 5 N.

T. 4 N.

35
2
f.c.

T. 3 N., R. 26 E. W. M.

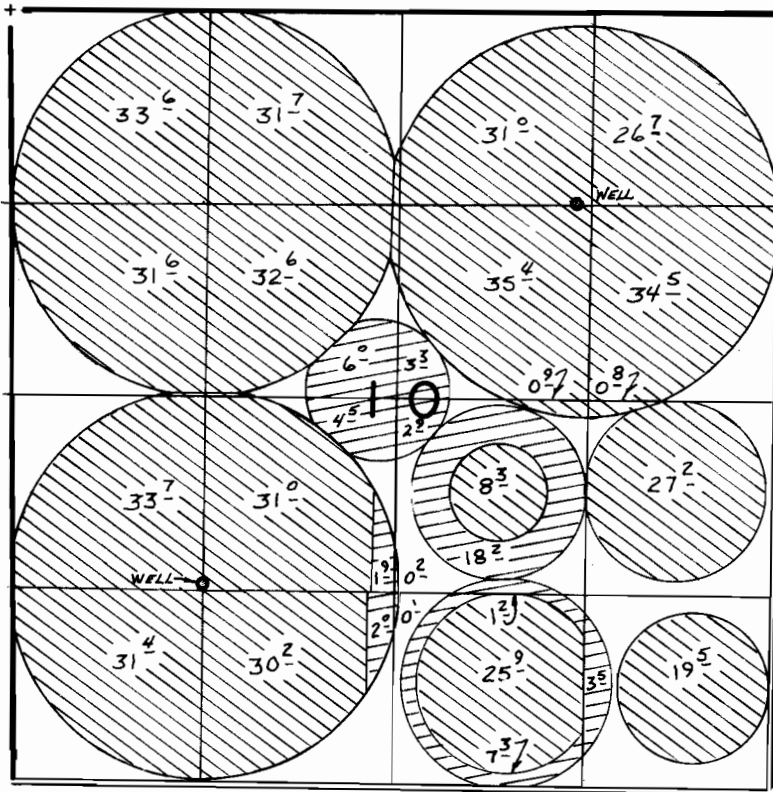

DIV. Pt. C.I.D. Loc: 150'S. AND
2990'W. FROM NE COR.
SEC. 2



SUPPLEMENTAL



PRIMARY

FINAL PROOF SURVEY
UNDER

Application No. **61230** Permit No. **45563**
IN NAME OF

JERRY BREWER

Surveyed **DEC. 13** 19**83**, by *V.L. Church*