RECEIVED

JUL 30 2012

WATER RESOURCES DEPT
SALEM, OREGON

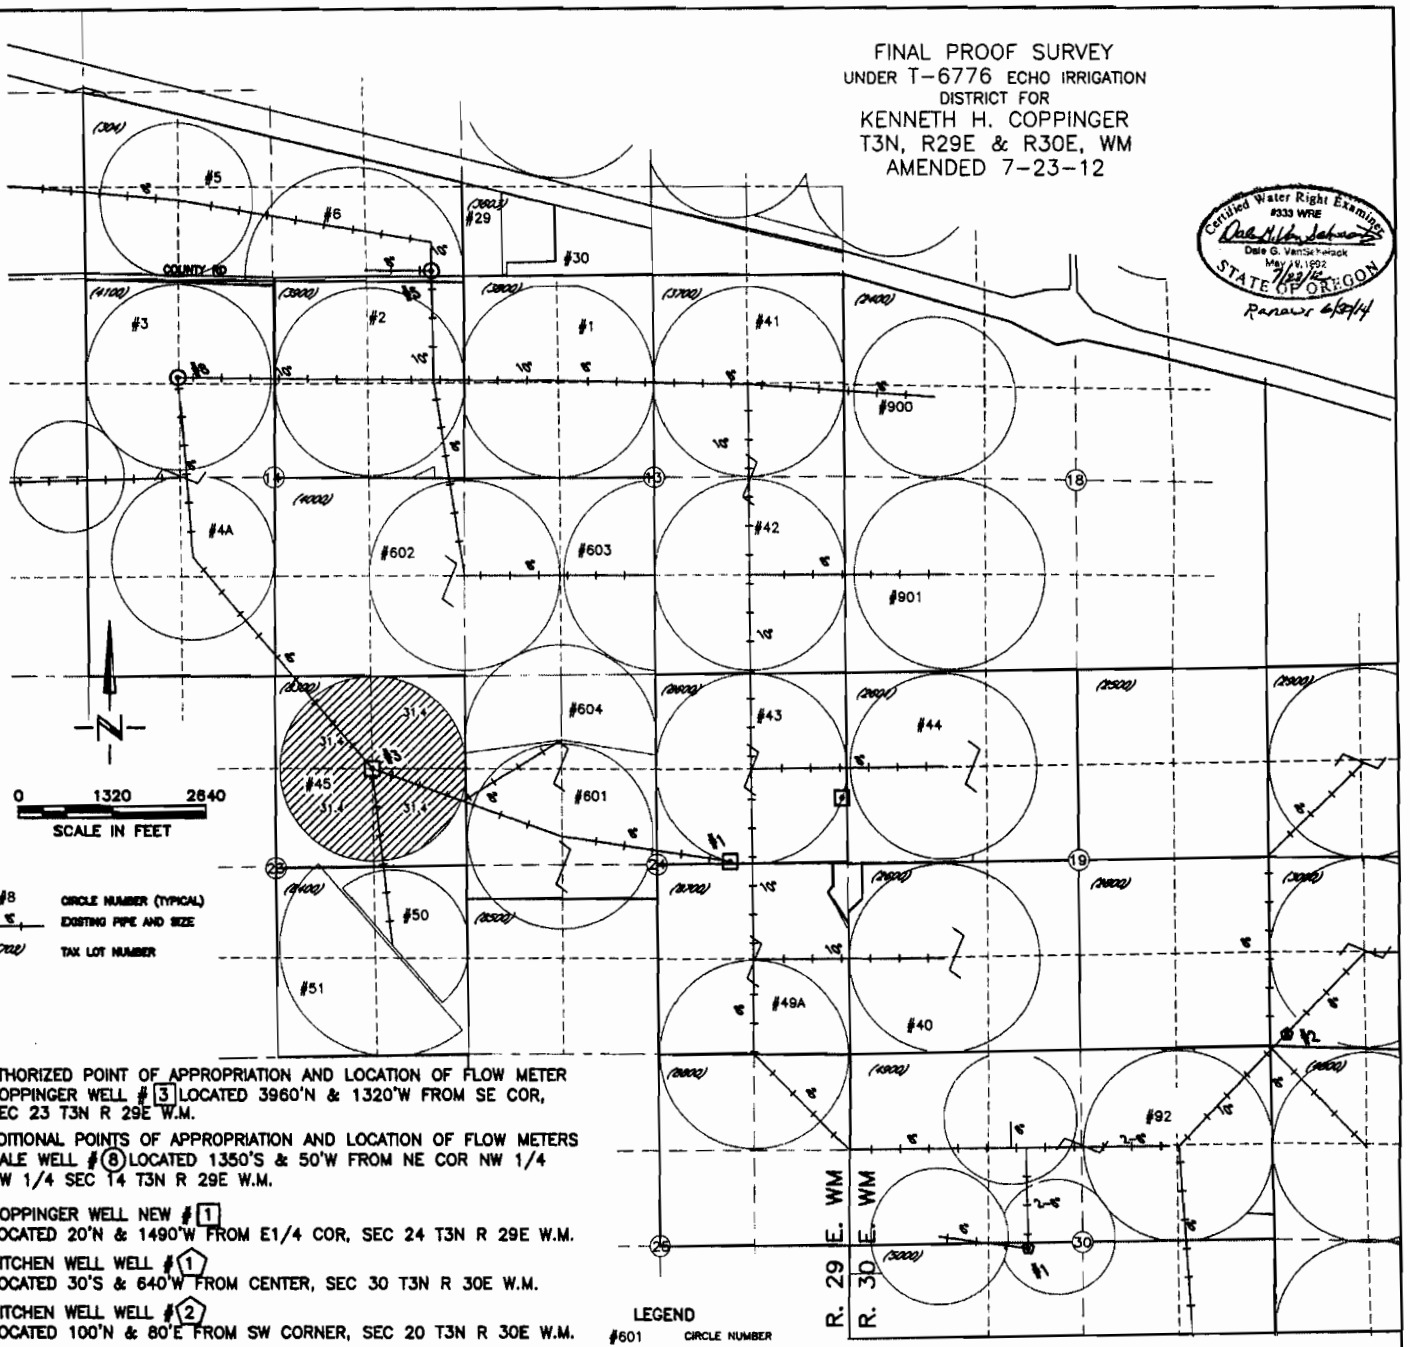

AUTHORIZED POINT OF APPROPRIATION AND LOCATION OF FLOW METER
COPPINGER WELL # 3 LOCATED 3960'N & 1320'W FROM SE COR, SEC 23 T3N R 29E W.M.

ADDITIONAL POINTS OF APPROPRIATION AND LOCATION OF FLOW METERS
HALE WELL # 8 LOCATED 1350'S & 50'W FROM NE COR NW 1/4 NW 1/4 SEC 14 T3N R 29E W.M.

COPPINGER WELL NEW # 1
LOCATED 20'N & 1490'W FROM E1/4 COR, SEC 24 T3N R 29E W.M.

DITCHEN WELL WELL # 1
LOCATED 30'S & 640'W FROM CENTER, SEC 30 T3N R 30E W.M.

DITCHEN WELL WELL # 2
LOCATED 100'N & 80'E FROM SW CORNER, SEC 20 T3N R 30E W.M.

THIS FINAL PROOF SURVEY MAP WAS AMENDED ON 7-23-12 TO INDICATE THE FLOW METERS ARE LOCATED AT THE WELLS

NOTE: THE PURPOSE OF THIS MAP IS TO IDENTIFY THE APPROXIMATE LOCATION OF THE WATER RIGHT. IT IS NOT INTENDED TO PROVIDE INFORMATION RELATIVE TO THE LOCATION OF PROPERTY OWNERSHIP BOUNDARY LINES.

DRAWING: F:\Project\30-08-016 - Perfly Water Rights Consulting\-00 Misc Engineering\Dwf\Gulassaha\30-08-016 Gulas FP.dwg
PRINTED BY: rwilard on 07/23/12 08:36 AM