

RECEIVED

JAN 12 2005

WATER RESOURCES DEPT
SALEM, OREGON

IN SECTION 32,
TWP.1 N., RANGE 13 E. W.M.
WASCO COUNTY, OREGON

NOTE:

SUPPLEMENTAL ACREAGE, CERT. 75458
IS SAME ACREAGE PLUS SUPPLEMENTAL
ON PRIMARY CERTIFICATE 75457.

CLAIM OF
BENEFICIAL USE MAP

SCALE: 1" = 400'

T-8903
75457 PRIMARY
75458 SUPPLEMENTAL
CERTIFICATE No. 75458 SUPPLEMENTAL
PERMIT No. G-482 PRIMARY, G-485 SUPPL.

IN THE NAME OF:


EDWARD H. MARTIN (T.L. 600)
ORCHARD MEADOWS, LLC (T.L. 200)

DATE: JANUARY 7, 2005

BY: TENNESON ENGINEERING CORP.
409 LINCOLN STREET,
THE DALLES, OREGON. 97058
PH. 541-296-9177
FAX 541-296-6657

NOTE:


"THIS MAP IDENTIFIES THE LOCATION OF
THE WATER RIGHT ONLY AND IS NOT
INTENDED TO PROVIDE DIMENSIONS OR
LOCATE PROPERTY OWNERSHIP LINES."

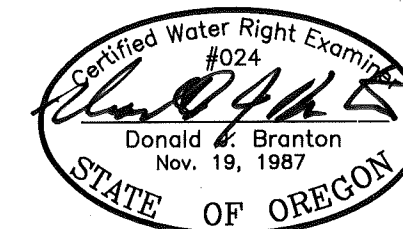

RENEW: 12/31/05

W.O. #10245

SECTION COR., CALC.
FROM 1" IRON ROD
BEARING OBJECTS,
PER REFERENCES

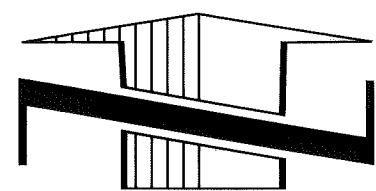

0' 200' 400' 800'

SCALE IN FEET

T.L. 100
THREEMILE COUNTY ROAD #161

PARCEL 1
TAX LOT 200 (1N-13-32)
WELL #2
WELL #1
T.L. 201
PARCEL 2
BOOSTER PUMP
S.W.1/4 OF 2.85 AC.
N.E.1/4

2100'
T.L. 300
S.E.1/4 OF N.E.1/4 1900'
N 89°52'44" W 1384.22'

(E) 10' DIRT ROAD
TAX LOT 400 (1N-13-32)
2.85 AC.

TAX LOT 600 (1N-13-32)
CS 2003-0524
P.P. 2001-016
1.71 AC.
T.L. 600

N.E.1/4 OF S.W.1/4 1.71 AC.

N.W.1/4 OF S.E.1/4
TAX LOT 200 (1N-13-32)

PARCEL 1
233.22 AC.
(UNSURVEYED)

S.W.1/4 OF S.E.1/4
CREEK

0.1 AC.
S.E.1/4 OF S.E.1/4

AREA TO BE TRANSFERRED IN
1.71 AC. (T.L. 600) + 2.85 AC.
(T.L. 200) = 4.56 AC. (TOTAL)

HOG BACK ROAD
TAX LOT 500

INITIAL POINT
FND. BENT PIPE
WITH BRASS CAP
PER REFERENCES.

29 28
32 33
2008.26'
2632.99'
N 00°07'16" W
(BASIS OF BEARING)
624.73'

(NORTH-SOUTH - 1320')

(NORTH-SOUTH - 1320')

(NORTH-SOUTH)

(NORTH-SOUTH)