

Shotgun Road

T. 17 S.,  
R. 19 E., W.M.

**RECEIVED**


MAR 26 2012

WATER RESOURCES DEPT  
SALEM, OREGON




Scale 1" = 1320'  
(4" = 1 mile)

App R-87400  
Per R-14754

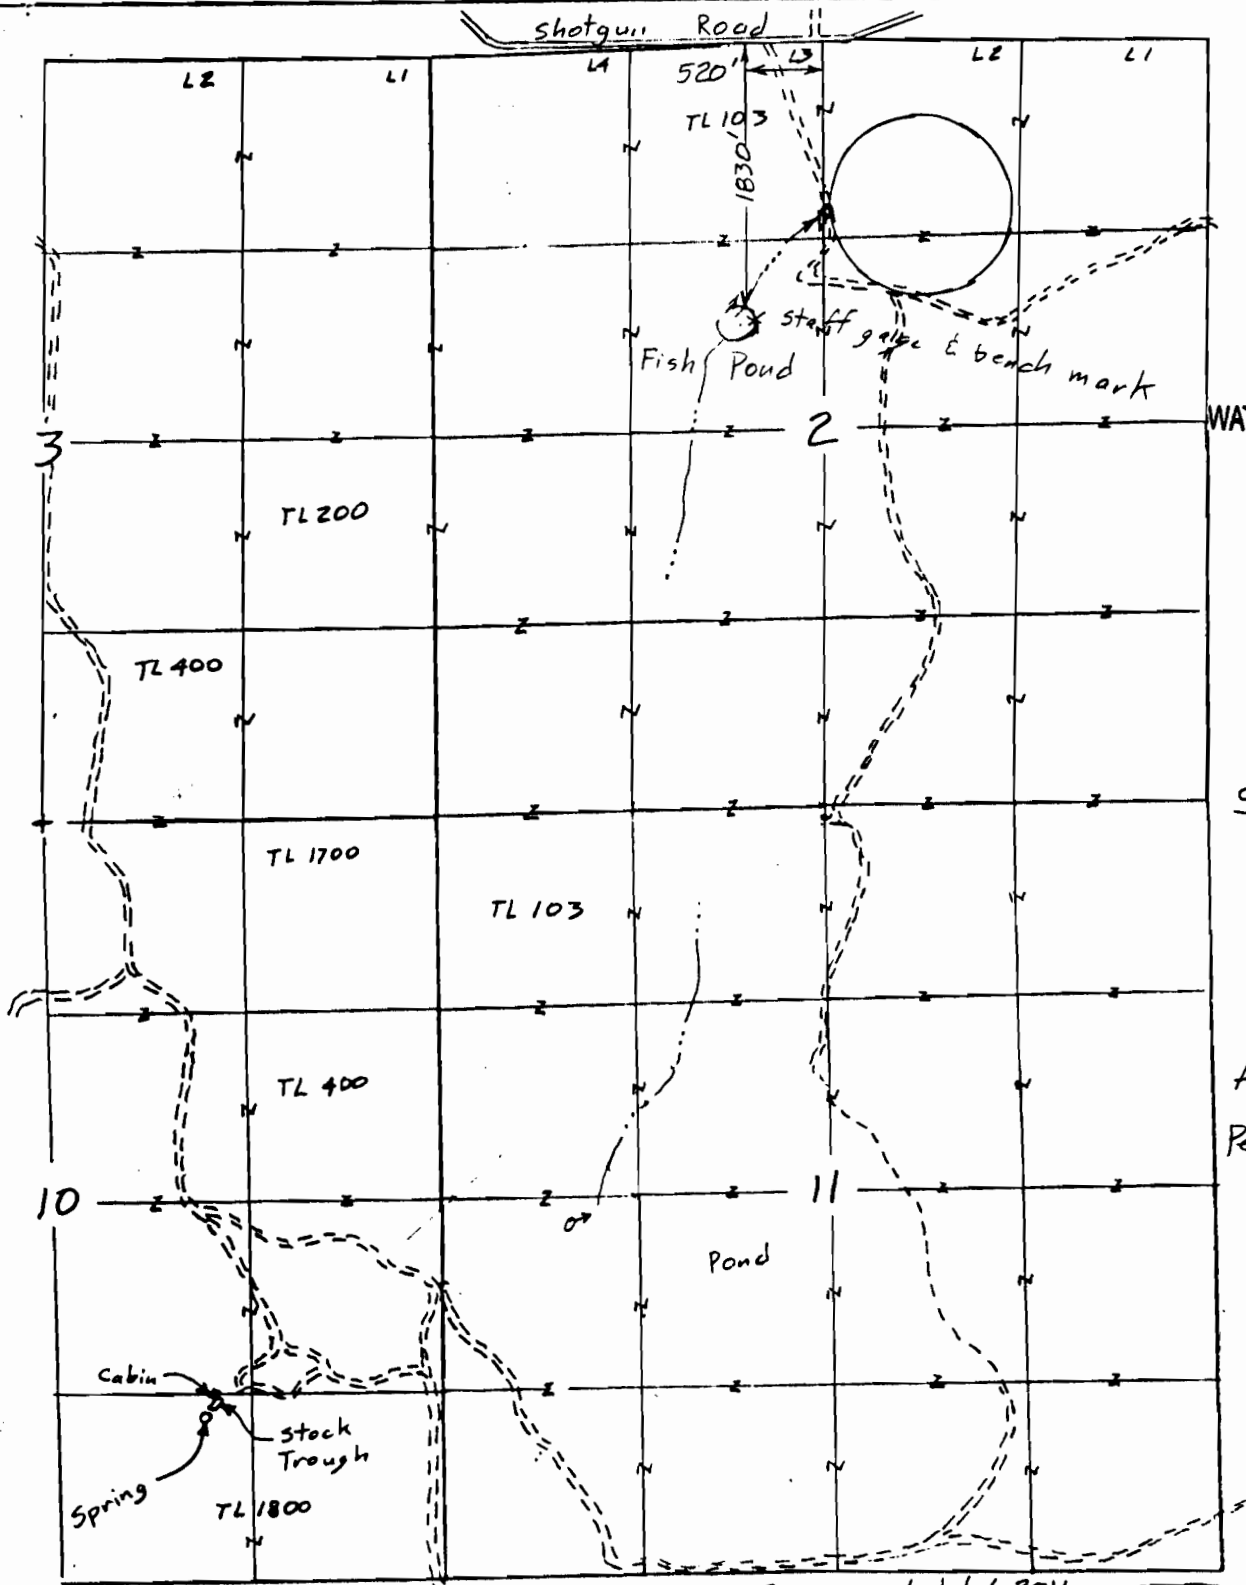

Surveyed July 6, 2011

### Claim of Beneficial Use Map for Shotgun Ranch, LLC

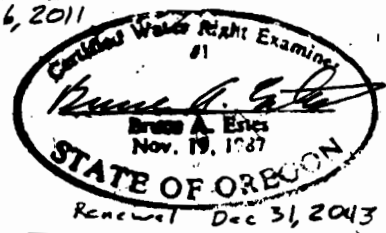

This map is for the purpose of  
locating a water right only  
and has no intent to provide  
legal dimensions or the location  
of property lines.

**ESTES SURVEYS, LLC**

P.O. Box 17519  
Salem, OR 97305-7519  
(503) 565-7503

60382 Arnold Rd  
Bend, OR 97702  
(541) 382-7301