

T. 17.S.,  
R. 19E, W.M.

**RECEIVED**

MAR 26 2012


WATER RESOURCES DEPT  
SALEM, OREGON



Scale 1" = 1320'  
(4" = 1 mile)


App R-87398

Per R-14752

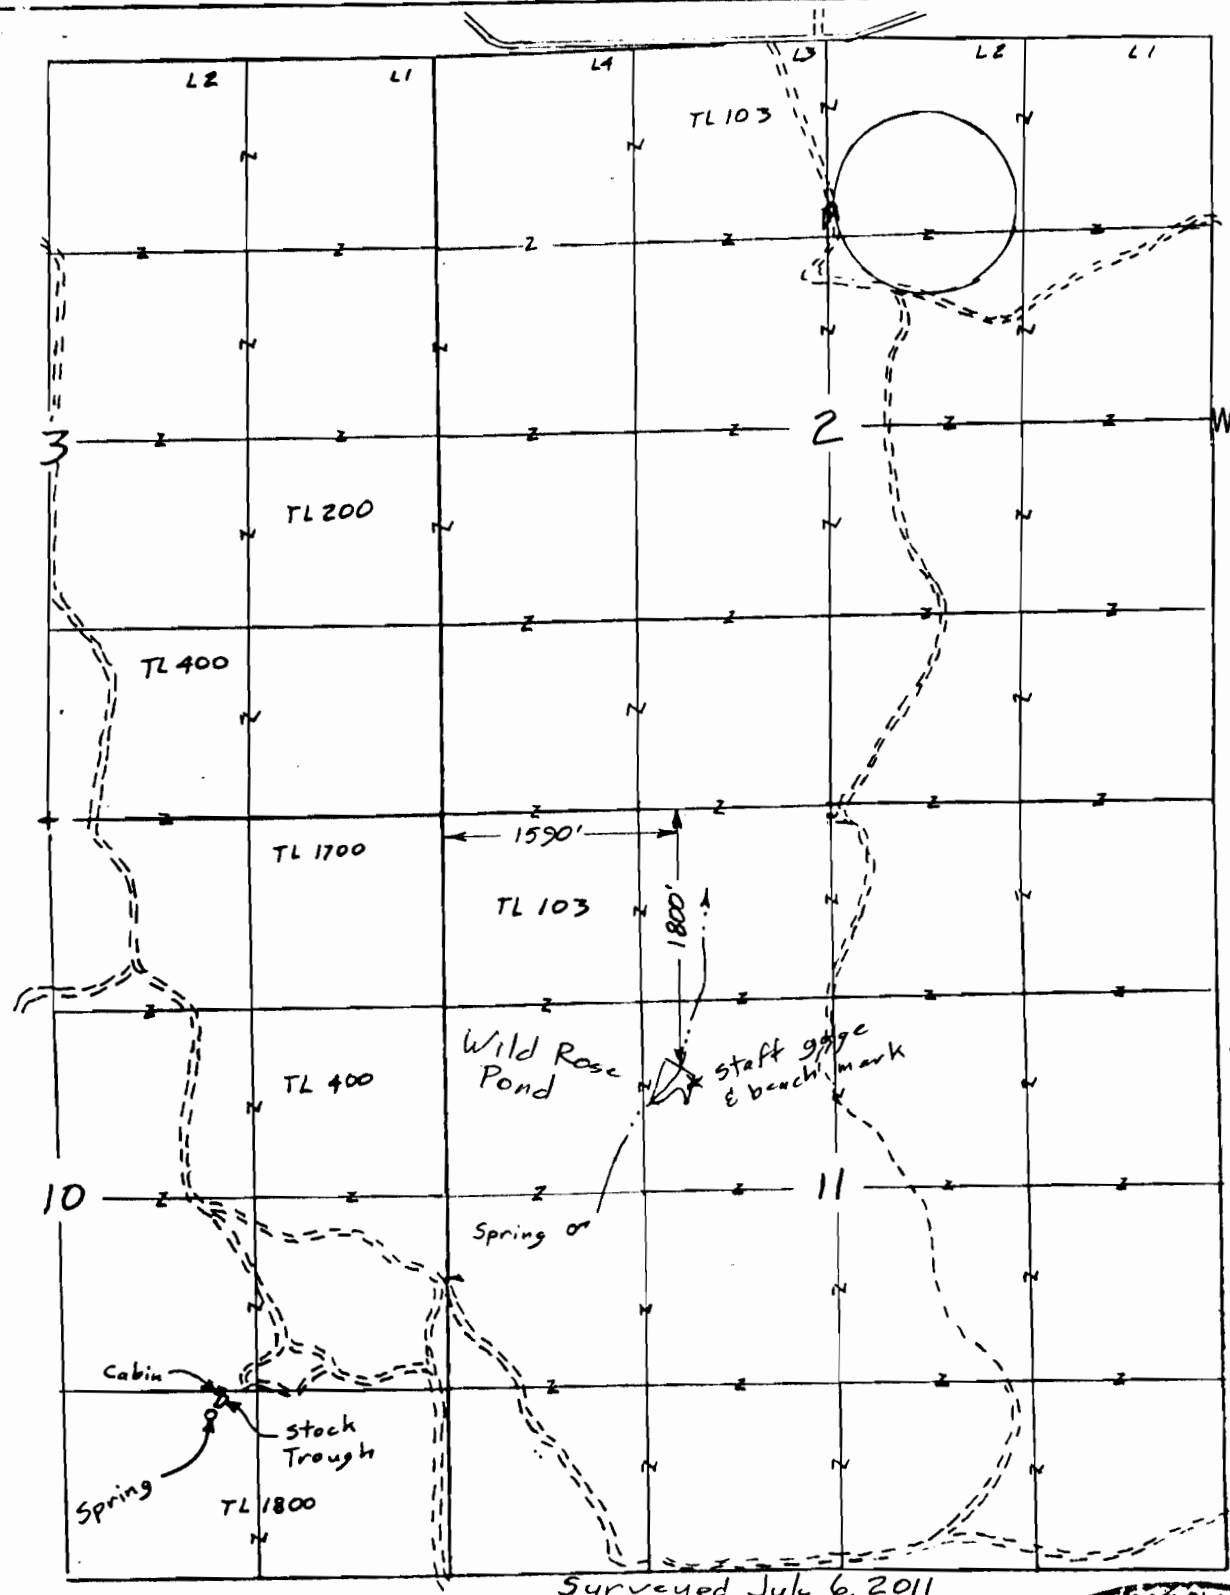

Claim of Beneficial  
Use Map  
for  
Shotgun Ranch, LLC

This map is for the purpose of  
locating a water right only  
and has no intent to provide  
legal dimensions or the location  
of property lines.

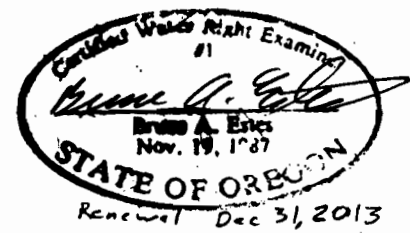

**ESTES SURVEYS, LLC**

PO Box 47610, 60382 Arnold Rd  
Salem, OR 97306-7610 Bend, OR 97702  
(503) 586-7608 (541) 382-7301