

9

10

16

15

14


21

22

23

28

27

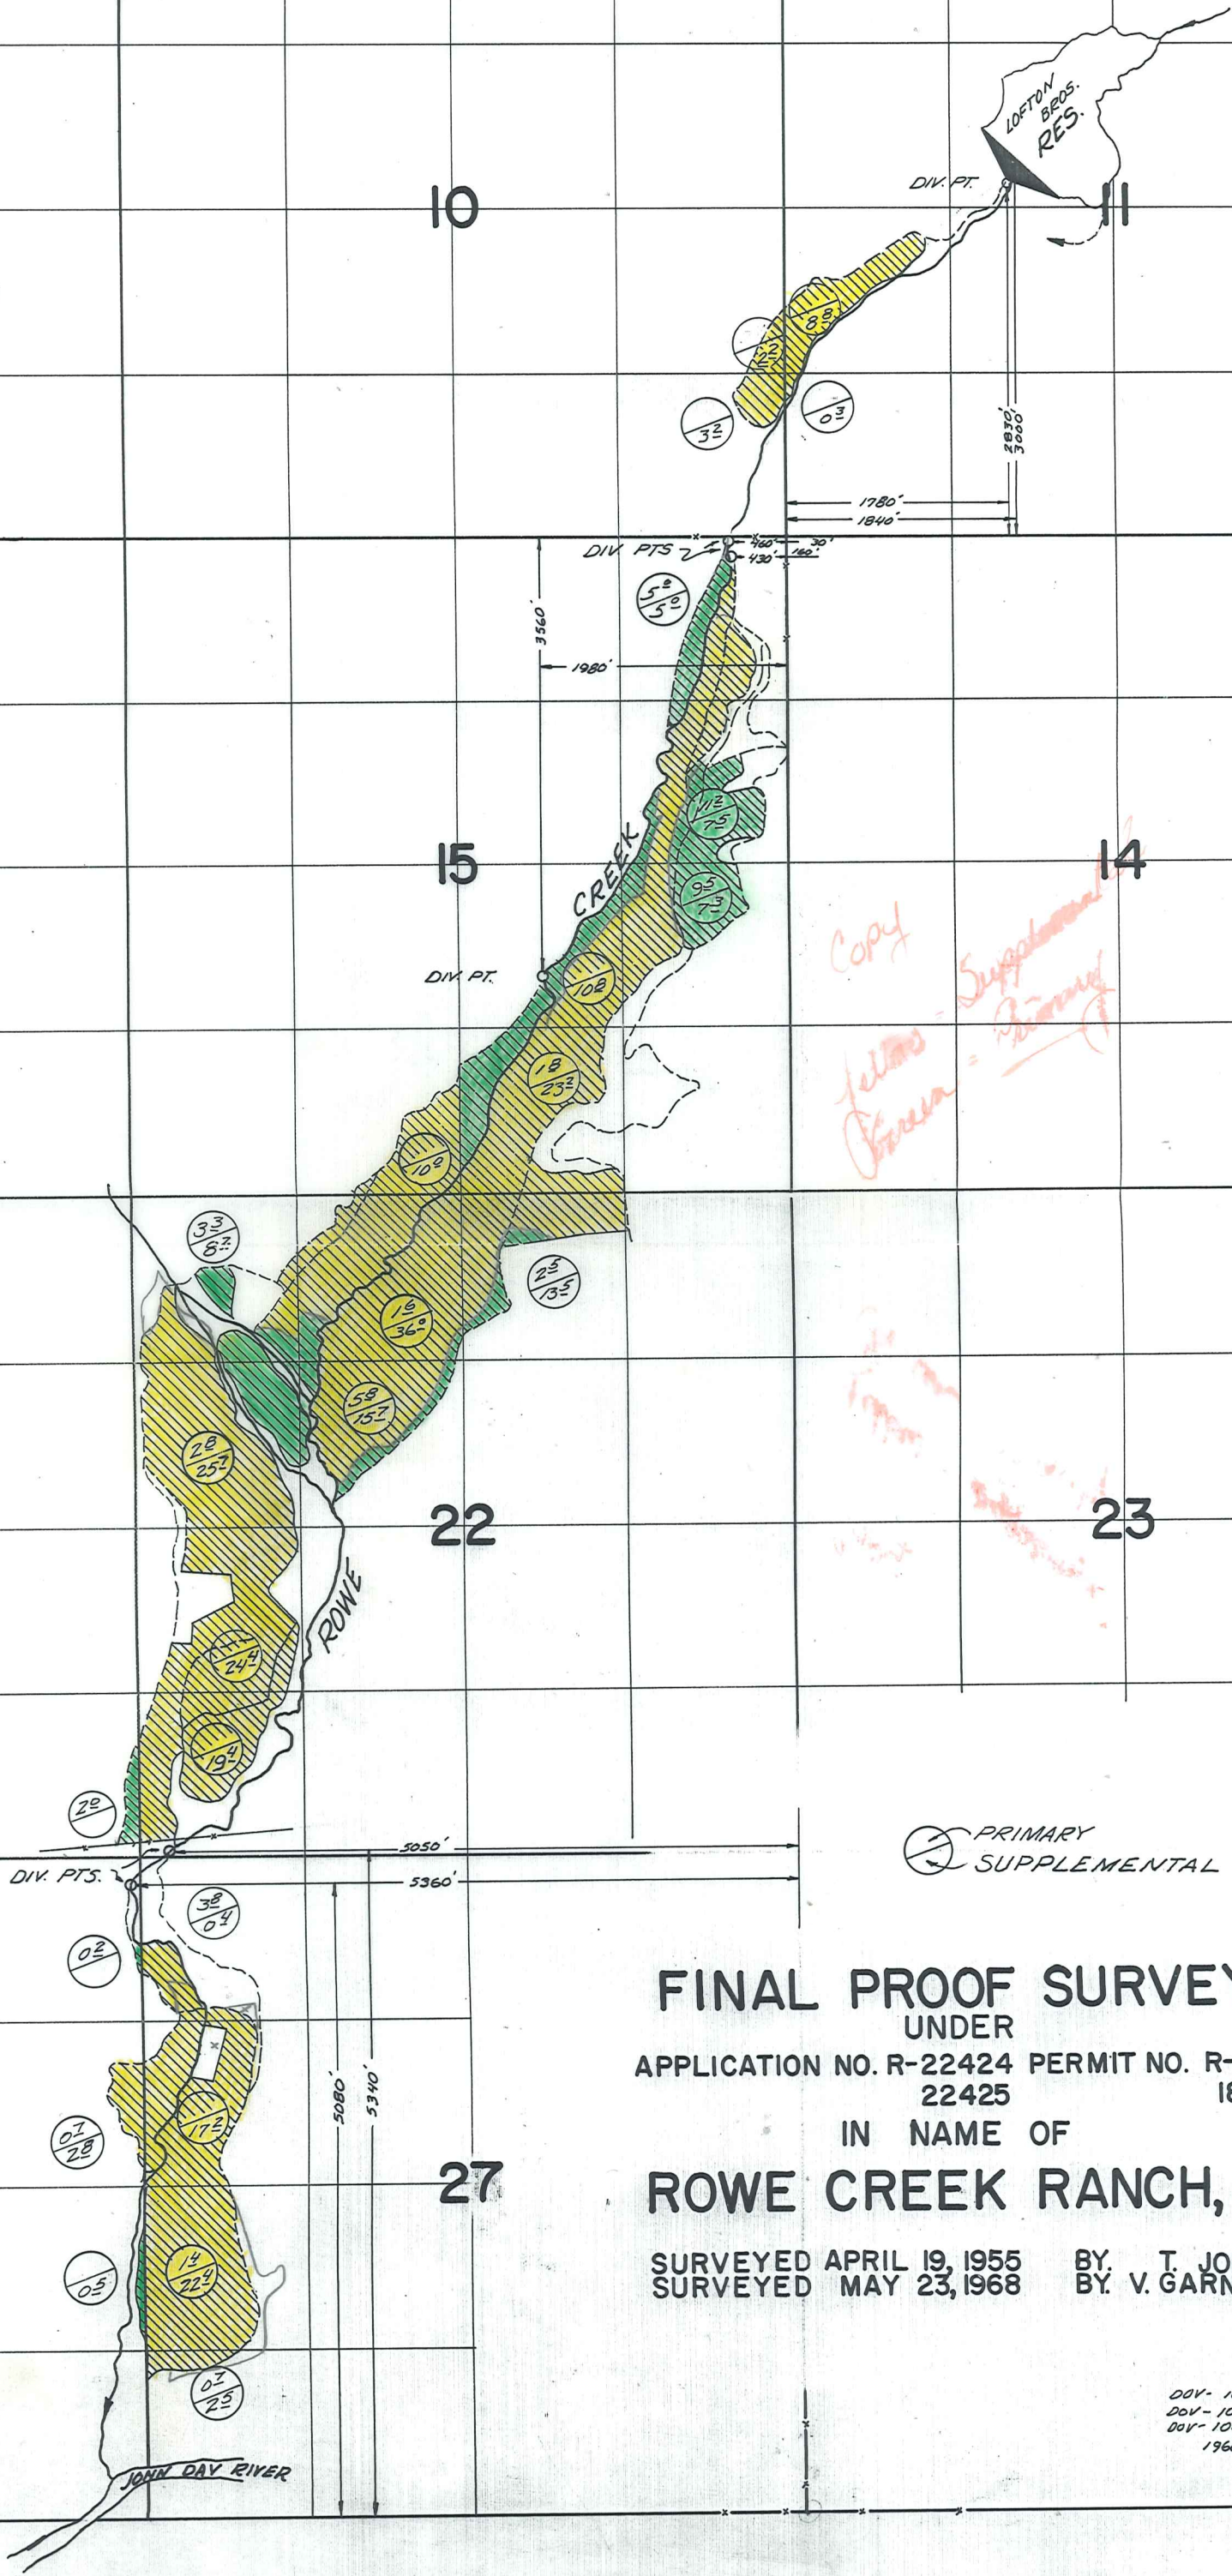

Copy

PRIMARY
SUPPLEMENTAL

FINAL PROOF SURVEY
UNDER
APPLICATION NO. R-22424 PERMIT NO. R-930
22425 18275
IN NAME OF
ROWE CREEK RANCH, INC.
SURVEYED APRIL 19, 1955 BY. T. JONES
SURVEYED MAY 23, 1968 BY. V. GARNER

DDV- 104 51
DDV- 104 53
DDV- 104 94
1968 B.